

M 97-51

FILED RECEIVED BS

NOV 2 1984

OREGON CORNER RESTORATION FORM

Section 10 Township 21S Range 8W
County DOUGLAS Date 10/12/84

COUNTY SURVEYOR
DOUGLAS COUNTY, ORE.

Corner Designation

WITNESS

CORNER TO CENTER EAST 1/16 CORNER


- Condition Report Only
- Not Found
- Renewed
- Unrecorded
- Surveyed In
- Referenced Out

Previous Renewals/Surveys, etc. _____

Monument(s) & Accessories Found: (Condition and Source)

Monument Detail

Sketch

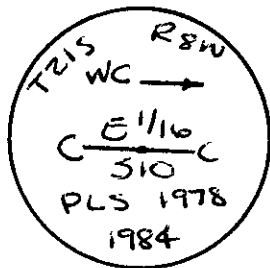

Monument Set (Procedures and Description)

2 1/2" ALUMINUM MONUMENT (T.P.C.)
WITH MAGNET IN BASE

FOR WITNESS CORNER TO CENTER EAST 1/16 CORNER
(TRUE CORNER POINT FALLS IN SMITH RIVER AND BEARS
New Accessories 568°19'05E, 69.00 FT)


9" FIR, S66°W, 24.2 FT. TO W.C. (SCRIBED X BT)

12" FIR, N44 1/2°W, 85.3 FT. TO W.C. (SCRIBED X BT)

Location & Comments

Surveyor's Seal

Compass Declination 20°
 Firm/Agency PEEL BAKER
LAND SURVEYING, INC.
 Address 1262 LAWRENCE
EUGENE, OREGON
 Party Chief DAN BAKER
 Notes _____
 Witness DARYL STANLEY

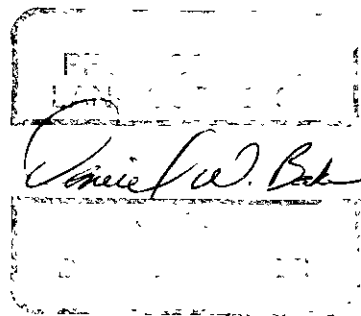

C.S. File No. 58/289 (N) ³⁹ c