

M 97-51

(2)

FILED
RECEIVED *BS*

NOV 2 1984

OREGON CORNER RESTORATION FORM

Section 10 Township 215 Range 8W

COUNTY SURVEYOR
DOUGLAS COUNTY, ORE.

County DOUGLAS Date 10/12/84

Corner Designation

$\frac{1}{4}$ CORNER $\frac{S10}{S15}$

- Condition Report Only
- Not Found
- Renewed
- Unrecorded
- Surveyed In
- Referenced Out

Previous Renewals/Surveys, etc. _____

1954 DEPENDENT RESURVEY

Monument(s) & Accessories Found: (Condition and Source)


1" I.P. WITH G.L.D BRASS CAP "1954"

2" CEDAR STUMP, N5°W, 71 $\frac{1}{2}$ FT. (1954 B.T.)
(SCRIBING VISIBLE)

SOUTHWEST B.T. GONE

Monument Detail

Sketch

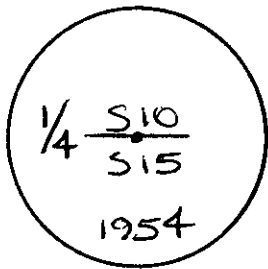

Monument Set (Procedures and Description)


New Accessories

8" FIR, N4°W, 45 $\frac{1}{2}$ FT.
SCRIBED $\frac{1}{4}$ S10 B.T.

Location & Comments

Surveyor's Seal

Compass Declination 20°
 Firm/Agency PEEL BAKER
LAND SURVEYING INC
 Address 1262 LAWRENCE
EUGENE, OREGON
 Party Chief DAN BAKER
 Notes _____
 Witness DARYL STANLEY

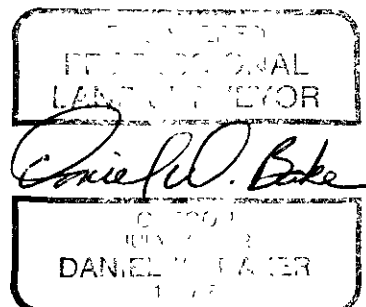

C.S. File No. 58/289(N) -36