

CORNER RENEWAL FOR THE CE1/16, SECTION 22, TOWNSHIP 22 SOUTH,  
RANGE 12 WEST, WILLAMETTE MERIDIAN, DOUGLAS COUNTY, OREGON


A road, to be constructed, would destroy this corner monument and its accessories. I, therefore, set three reference points and removed the monument.

After the road was constructed and surfaced with crushed rock, I reset the monument in its original position. This corner lies in a road bed at the intersection of two roads. I set the corner monument one foot below the road surface.


I marked a 10" Alder which bears N58°W 23.8 feet scribed "CE1/16 S22 BT" - attached a metal bearing tree tag.

I set a 5/8" x 30" iron rod in the road cut which bears south 42.2 feet - attached a metal bearing tree tag.

This corner monument is a 2-1/2" iron pipe with brass cap marked CE1/16 S22 LS 1091. This corner was originally set by Robert B. Ward, Jr. LS 1091 in June, 1982.

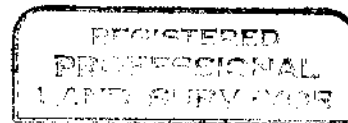

*Burton W. Holt*

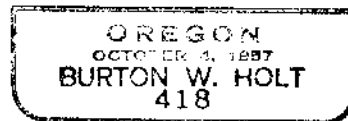

P.O. Box 1127

Roseburg, Oregon 97470

*at 16m*

FILED  
RECEIVED *BJ*  
APR 6 1984  
COUNTY SURVEYOR  
DOUGLAS COUNTY, ORE