

FILED
RECEIVED *jt*

NOV 8 1984

COUNTY SURVEYOR
DOUGLAS COUNTY, ORE.

OREGON CORNER RESTORATION FORM

Section 1 Township 28S Range 1E

County DOUGLAS Date 10-12-84

Corner Designation

T28S
2 | 1
11 | 12
R1E

- Condition Report Only
- Not Found
- Renewed
- Unrecorded
- Surveyed In
- Referenced Out

Previous Renewals/Surveys, etc.

192


(1227 610)

Monument(s) & Accessories Found: (Condition and Source)


FD 2" IRON PIPE WITH BRASS CAP MARKED "US GENERAL
LAND OFFICE 11/12 192 " FIRMLY SET PROTRUDING
4 IN. OUT OF THE GROUND

FD A 48" PINE BEAR S 59° W, 25.5 FT (REC S 61° 4' W, 25.7 FT)
WITH VISIBLE SCRIBE "S 11 BT"

Monument Detail

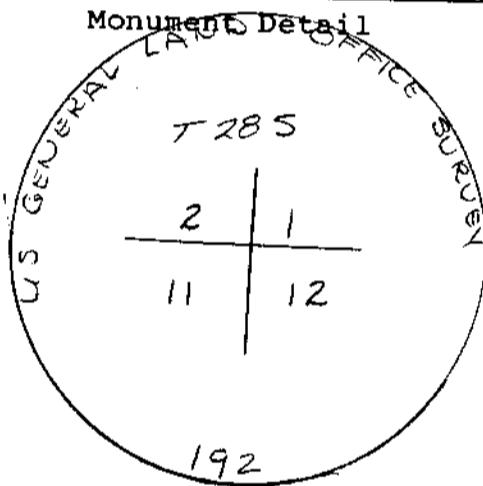

Sketch

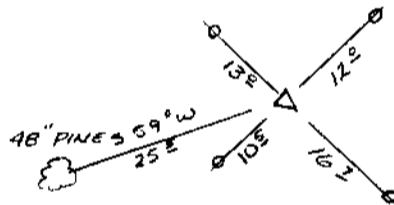

Monument Set (Procedures and Description)

NONE

New Accessories B.O.

A 5/8" X 30" IRON ROD WITH PLASTIC CAP "AA SURVEYING SERVICE INC"
BEARS N 45° E, 12² FT.

A 5/8" X 30" IRON ROD WITH PLASTIC CAP "AA SURVEYING SERVICE INC"
BEARS S 45° E, 16² FT.

A 5/8" X 30" IRON ROD WITH PLASTIC CAP "AA SURVEYING SERVICE INC" (SEE #62)

Location & Comments

COR FALLS IN
LARGE CLEARCUT
UNIT

Compass Declination 19 1/2 E

Firm/Agency AA SURVEYING
SERVICE INC

Address PO. BOX 130
ROSEBURG OREGON

Party Chief RON QUIMBY LS

Notes RON QUIMBY

Witness DARREL JONES

Surveyor's Seal

REGISTERED
PROFESSIONAL
LAND SURVEYOR

Ronald A. Quimby

OREGON
JULY 14, 1978
RONALD A. QUIMBY
1654

C.S. File No. 58/290-7

6 ✓

FILED
RECEIVED *LR*

NOV 8 1984

OREGON CORNER RESTORATION FORM

Section 1 Township 28S Range 1E

County DOUGLAS Date 10-12-84

COUNTY SURVEYOR
DOUGLAS COUNTY, ORE.

Corner Designation

7285
2/1
11/12
R1E

- Condition Report Only
- Not Found
- Renewed
- Unrecorded
- Surveyed In
- Referenced Out

Previous Renewals/Surveys, etc. _____

Monument(s) & Accessories Found: (Condition and Source)

Monument Detail

Sketch

Monument Set (Procedures and Description)

New Accessories

BEARS S45° W, 10.5 FT
A 5/8" x 30" IRON ROD WITH PLASTIC CAP "AA SURVEYING SERVICE INC"
BEARS N 45° W 13° FT.

Location & Comments

Compass Declination _____
Firm/Agency _____
Address _____
Party Chief _____
Notes _____
Witness _____

Surveyor's Seal

REGISTERED
PROFESSIONAL
LAND SURVEYOR

Ronald A. Quimby

OREGON
JULY 14, 1978
RONALD A. QUIMBY
1654