

FILED
RECEIVED *JH*

NOV 27 1984

OREGON CORNER RESTORATION FORM

Section 3 Township 29S Range 8W

COUNTY SURVEYOR
DOUGLAS COUNTY, ORE.

County Douglas Date 10/31/84

Corner Designation

E 1/16 Cor. - South line

- Condition Report ~~Only~~
- Not Found
- Renewed
- Unrecorded
- Surveyed In
- Referenced Out

Previous Renewals/Surveys, etc.

Brass Cap set per Survey # M 42-67 (Aug 1972)

Monument(s) & Accessories Found: (Condition and Source)

Found Brass Cap and 6" D. Fir BT as
described in Survey # M 42-67
6" W. Fir BT was cut in logging operation.

Monument Detail

Sketch

Monument Set (Procedures and Description)


New Accessories

Scribed new bearing tree: E 1/16 LS 749 BT
10" Douglas Fir bears N 52° E, 11.9 ft.

Location & Comments

Surveyor's Seal

Compass Declination 19° E
 Firm/Agency Gregory
Timber Resources Inc.
 Address PO Box C
Glandale, OR.
 Party Chief Duane Smith
 Notes _____
 Witness _____

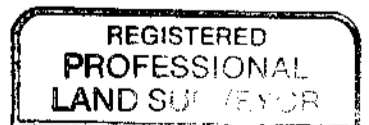

Thomas H. Mitchell
 OREGON
 JULY 5, 1986
 THOMAS H. MITCHELL
 745