

M 96-30

FILED
RECEIVED

APR 10 1984

OREGON CORNER RESTORATION FORM


Section 5 Township 21S Range 9W

County Douglas Date 3-27-84

COUNTY SURVEYOR
DOUGLAS COUNTY, ORE.

Corner Designation

C.W. 1/16 Corner
Section 5

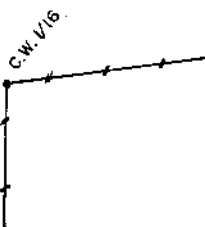

- Condition Report Only
- Not Found
- Renewed
- Unrecorded
- Surveyed In
- Referenced Out

Previous Renewals/Surveys, etc. See Survey M90-30 by Roberts
Surveying dated December 21, 1982


Monument(s) & Accessories Found: (Condition and Source)

Found $1\frac{1}{2}$ " x 36" Iron Pipe and Brass Cap set in Survey M90-30.
 20" Cedar, N86W, 43.7' (Scribe Vis.), 1982 B.T. Rec. N86W, 43.7'
 84" Fir, S44W, 66.6' (Scribe Vis.), 1982 B.T. Rec. S44W, 66.6'

Monument Detail

FD. $1\frac{1}{2}$ " x 36" IRON PIPE
AND BRASS CAP

Sketch

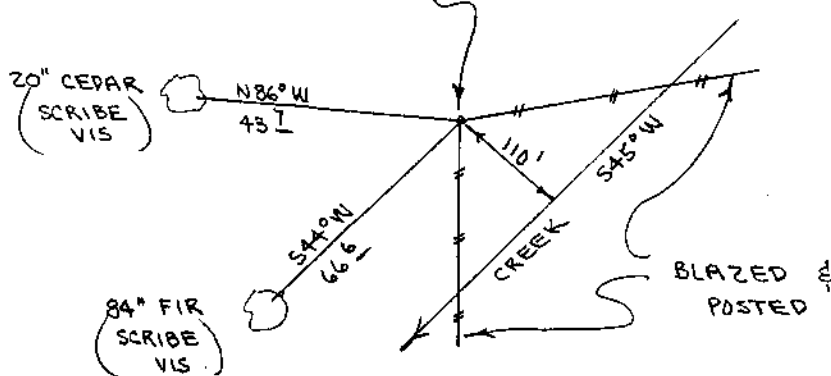

Monument Set (Procedures and Description)

New Accessories

None

Location & Comments

Corner falls on S.E. slope about 110' above small creek. Creek bears S45W.

Compass Declination 20 $\frac{1}{2}$
 Firm/Agency Roberts Surveying Inc.
 Address 29 West 29th St. Eugene, Oregon 97405
 Party Chief Les Roberts
 Notes Stu Duce
 Witness Marion Hunter

Surveyor's Seal

