

M 96-30

FILED
RECEIVED *BR*

OREGON CORNER RESTORATION FORM

APR 10 1984


Section 5 Township 21S Range 9W

COUNTY SURVEYOR
DOUGLAS COUNTY, ORE.

County Douglas Date 3-27-84

Corner Designation

Center $\frac{1}{4}$ Corner
Section 5

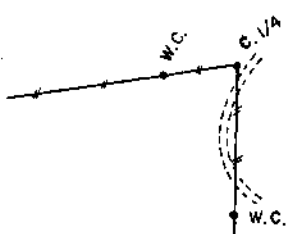

- Condition Report Only
- Not Found
- Renewed
- Unrecorded
- Surveyed In
- Referenced Out

Previous Renewals/Surveys, etc. See Survey M90-30 by Roberts
Surveying dated December 21, 1982


Monument(s) & Accessories Found: (Condition and Source)

Found $1\frac{1}{2}$ " x 36" Iron Pipe and Brass Cap set in Survey M90-30

14" Hemlock, S85E, 30.3' (Scribe Vis.), 1982 BT. Rec. S85E, 30.3'

29" Alder, N13E, 10.2' (Scribe Vis.), 1982 BT. Rec. N13E, 10.2'

Monument Detail

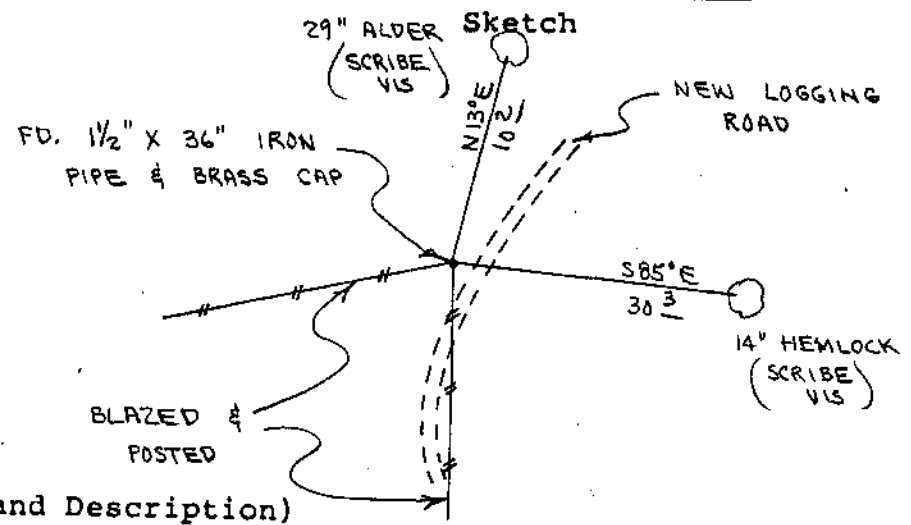

Monument Set (Procedures and Description)

New Accessories

None

Location & Comments

Corner falls on East slope in light stand of 150 year old green timber.

Compass Declination 20 $\frac{1}{2}$

Firm/Agency Roberts Surveying Inc.

Address 29 West 29th St. Eugene, Oregon 97405

Party Chief Les Roberts

Notes Stu Duce

Witness Marion Hunter

Surveyor's Seal

REGISTERED
PROFESSIONAL
LAND SURVEYOR

Les Roberts

OREGON
AUGUST 22, 1975
L. D. ROBERTS
1039

C.S. File No. 58/293 (1b)