

M 90-53

FILED ✓  
RECEIVED BS

APR 11 1984

OREGON CORNER RESTORATION FORM  
Section 34 Township 20S Range 9W  
County Douglas Date 2-14-84

COUNTY SURVEYOR  
DOUGLAS COUNTY, ORE.

Corner Designation

North  $\frac{1}{4}$  Corner  
Section 34  
27  
34


- Condition Report Only
- Not Found
- Renewed
- Unrecorded
- Surveyed In
- Referenced Out

Previous Renewals/Surveys, etc. Thomas A. Tillman and Joseph S. Hawron G.L.O. Survey in 1953-1954. Glenn and Jelley's Cadastral Survey dated 1967.

Monument(s) & Accessories Found: (Condition and Source)

Found 1953 G.L.O. Brass Cap set firmly in ground.  
50" Fir, S59W, 76.4' (Scar Vis.), 1953 BT. Rec. S59W, 72.6'  
N.E. Maple BT set in 1953 is gone.  
6" Alder, N16E, 13.6' (Scribe Vis.), 1967 BT. Rec. N16E, 13.9'

Monument Detail

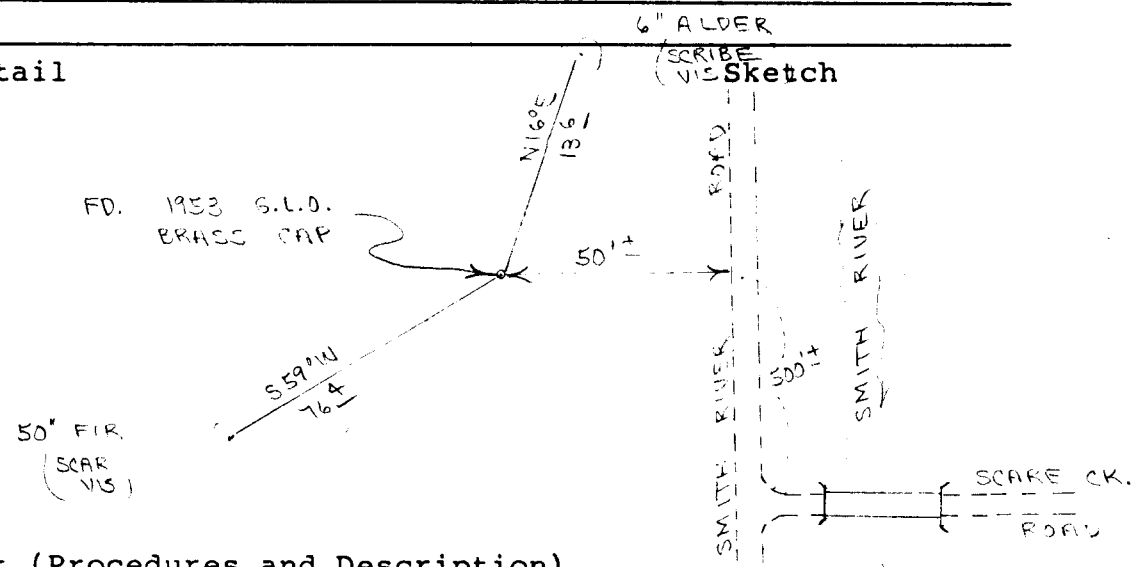

Monument Set (Procedures and Description)

\_\_\_\_\_  
\_\_\_\_\_  
\_\_\_\_\_

New Accessories

Set metal post beside brass cap. Wired survey attention sign to fence post.

Location & Comments

Corner lies on steep East slope about 50' West of Smith River Road. Corner is also about 500' North of Scare Creek Bridge.

Compass Declination 20 $\frac{1}{2}$   
Firm/Agency Roberts Surveying Inc.  
Address 29 West 29th St. Eugene, Oregon 97405  
Party Chief Les Roberts  
Notes Ted Baker  
Witness Stu Duce

Surveyor's Seal

