

M 90-53

FILED
RECEIVED *68*

OREGON CORNER RESTORATION FORM

APR 11 1984


Section 34 Township 20S Range 9W

COUNTY SURVEYOR
DOUGLAS COUNTY, ORE.

County Douglas Date 3-19-84

Corner Designation

East 1/16 Corner
Section 34

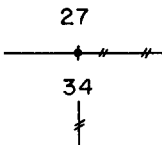

- Condition Report Only
- Not Found
- Renewed
- Unrecorded
- Surveyed In
- Referenced Out

Previous Renewals/Surveys, etc. Harvey Wofford's Cadastral
Survey dated 1933 (Unapproved)

Monument(s) & Accessories Found: (Condition and Source)


Found 1983 B.L.M. Brass Cap drilled in solid rock.

16" Fir, N87E, 96.2' (Scribe Vis.), 1983 BT. Rec.

18" Fir, S47E, 64.4' (Scribe Vis.), 1983 BT. Rec.

Monument Detail

Sketch

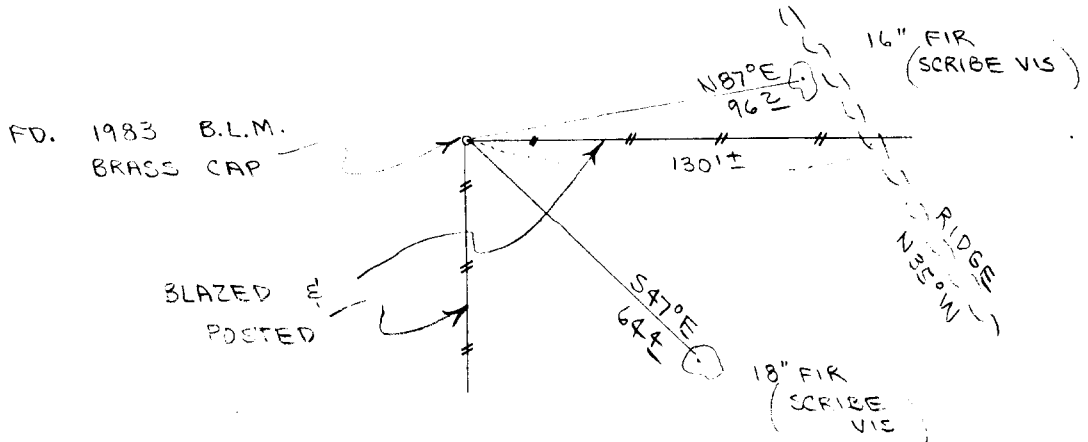

Monument Set (Procedures and Description)

New Accessories

Set metal fence post beside brass cap. Wired land survey
monument sign to fence post.

Location & Comments

Corner lies on rocky
S.W. Slope about 120'
West of narrow rocky
ridge. Ridge bears
S35E and N35W.

Compass Declination 20 1/2
Firm/Agency Roberts
Surveying Inc.
Address 29 West 29th St.
Eugene, Oregon 97405
Party Chief Ted Baker
Notes Stu Duce
Witness Buzz Moisan

Surveyor's Seal

