

M 90 - 53

FILED
RECEIVED *BS*

APR 11 1984

OREGON CORNER RESTORATION FORM


COUNTY SURVEYOR
DOUGLAS COUNTY, ORE.

Section 34 Township 20S Range 9W

County Douglas Date 2-16-84

Corner Designation

West $\frac{1}{4}$ Corner
Section 34

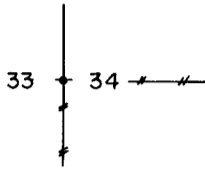

- Condition Report Only
- Not Found
- Renewed
- Unrecorded
- Surveyed In
- Referenced Out

Previous Renewals/Surveys, etc. Thomas A. Tillman and Joseph S. Gawron G.L.O. Survey in 1953-1954.

Monument(s) & Accessories Found: (Condition and Source)

Found 1953 G.L.O. Brass Cap set firmly in ground.

53" Cedar, N81W, 67.9' (No Marks), 1877 BT. Rec. N80 $\frac{1}{2}$ W, 66.0'

10" Hemlock Stub, N75E, 15.5' (Scribe Vis.), 1953 BT. Record


N77 $\frac{1}{4}$ E, 15.2'

19" Maple, N74W, 14.1' (Scar Vis.), 1953 BT. Rec. N75 $\frac{3}{4}$ W, 14.5'

N.E. Cedar BT set by Theil in 1877 and found in 1953 is gone.

Monument Detail

Sketch

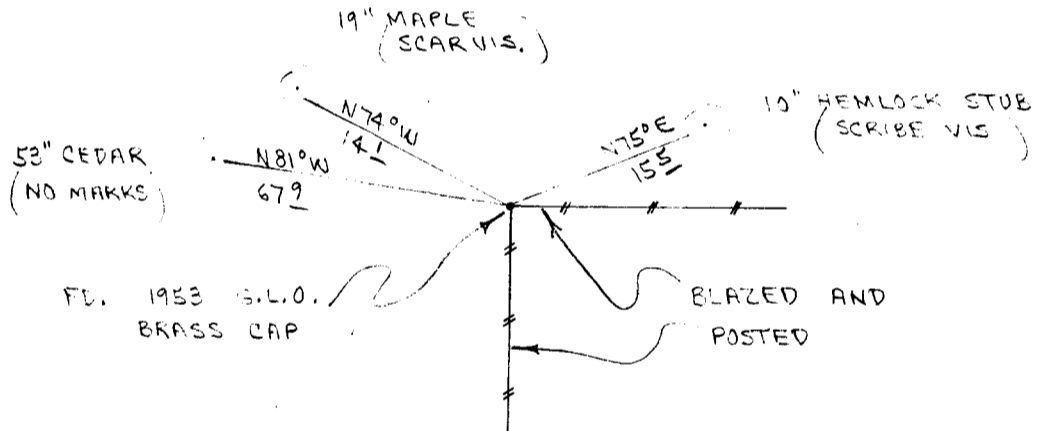

Monument Set (Procedures and Description)

New Accessories

Set metal fence post beside brass cap. Wired attention sign to fence post.

Location & Comments

Corner lies on West slope in NW corner of old unit. Logging unit is 10-15 years old

Compass Declination 20 $\frac{1}{2}$

Firm/Agency Roberts Surveying Inc.

Address 29 West 29th St. Eugene, Oregon 97405

Party Chief Ted Baker

Notes Stu Duce

Witness Buzz Moisan

Surveyor's Seal

