

M 90-53

FILED RECEIVED AS

APR 11 1984

OREGON CORNER RESTORATION FORM

COUNTY SURVEYOR DOUGLAS COUNTY, ORE.

Section 34 Township 20S Range 9W

County Douglas Date 3-23-84

Corner Designation

N.E. 1/16 Corner Section 34




- Condition Report Only
- Not Found
- Renewed
- Unrecorded
- Surveyed In
- Referenced Out

Previous Renewals/Surveys, etc. None

Monument(s) & Accessories Found: (Condition and Source)

Monument Detail

Sketch

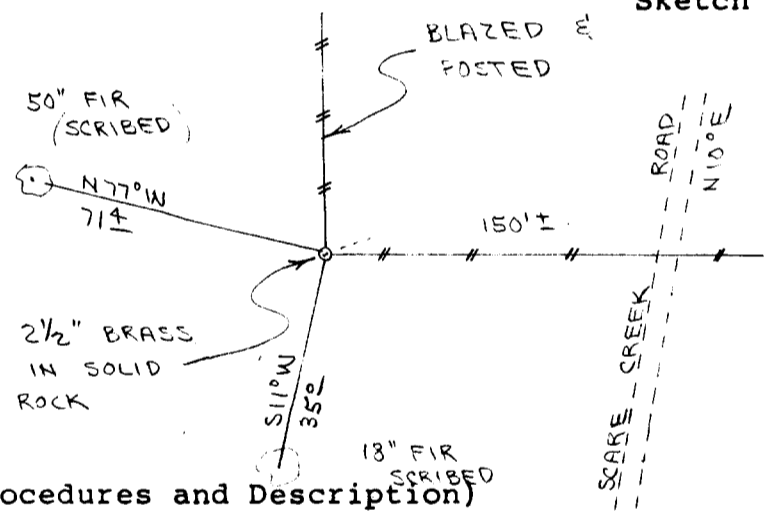

Monument Set (Procedures and Description)

Set 2 1/2" Brass Cap in drill hole in solid rock. Cap stamped S-T-R, date and P.L.S. No. 1039. See filed survey for survey procedures.

18" Fir, S11W, 35.0' (Scribed/Painted Red/Brass Washer)

50" Fir, N77W, 71.4' (Scribed/Painted Red/Brass Washer)

New Accessories

Set metal fence post beside aluminum cap. Wired land survey monument sign to fence post.

Location & Comments

Corner lies on NE slope about 150' west of Scare Creek Road.

Compass Declination 20 1/2

Firm/Agency Roberts Surveying Inc.

Address 29 West 29th St. Eugene, Oregon 97405

Party Chief Ted Baker

Notes Stu Duce

Witness Buzz Moisan

Surveyor's Seal

