

N 98-19

OREGON CORNER RESTORATION FORM

Section 30 Township 19S Range 8W

County Douglas Date 1-08-85

Corner Designation

East $\frac{1}{4}$ Corner
Section 30.

30 | 29

- Condition Report Only
- Not Found
- Renewed
- Unrecorded
- Surveyed In
- Referenced Out

Previous Renewals/Surveys, etc. Original Survey by C.M. Collier in 1891. 1980 B.L.M. renewal by Lester Fischer.

Monument(s) & Accessories Found: (Condition and Source)
Original Post Gone.

Found 1980 B.L.M. Brass Cap set firmly in mound of stone.


48" Fir, N64E, 26.5' (Scribe Vis.), 1891 BT. Rec. N64 3/4E, 27.1'

6" Fir, S51W, 22.5' (Scar Vis.), 1980 BT. Rec. S52 1/4W, 21.8'

Found metal fence post beside mound of stone.

Monument Detail

Sketch

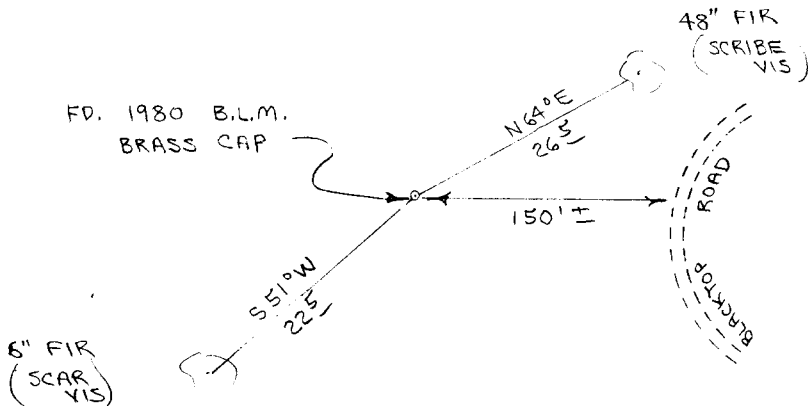

Monument Set (Procedures and Description)

New Accessories

Wired land survey monument sign to fence post.

Location & Comments

Corner lies on steep Compass Declination 20 1/2

N.W. slope about Firm/Agency Roberts

150' West of black- Surveying Inc.

top road. Address 29 West 29th St.

Eugene, Oregon 97405

Party Chief Les Roberts

Notes

Witness Ted Baker

Surveyor's Seal

