

M 78-17

OREGON CORNER RESTORATION FORM

Section 30 Township 19S Range 8W

County Douglas Date 1-08-85

Corner Designation

N.W. Corner of
Section 30.

19
30

- Condition Report Only
- Not Found
- Renewed
- Unrecorded
- Surveyed In
- Referenced Out

Previous Renewals/Surveys, etc. 1957 G.L.O. Survey by Tillman and Survey M87-78 by Roberts Surveying in 1981.

Monument(s) & Accessories Found: (Condition and Source)


Found 1957 G.L.O. Brass Cap set firmly in ground.

21" Maple, N28½E, 19.1' (No marks), 1891 BT. Rec. N57E, 19.1'

17" Maple, N82E, 37.2' (Scar Vis.), 1957 BT. Rec. N81½E, 37.3'

18" Maple, S20E, 5.4' (Scar Vis.), 1957 BT. Rec. S16½E, 5.9'

Monument Detail

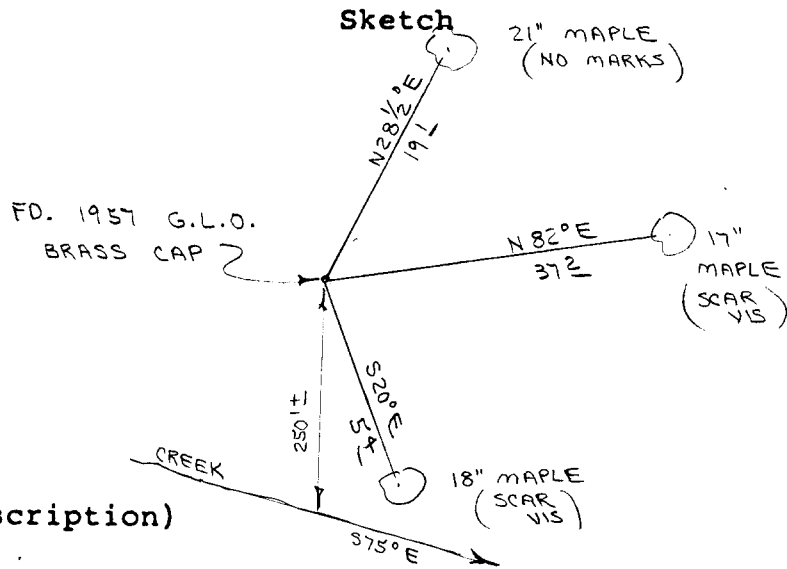

Monument Set (Procedures and Description)

New Accessories

None

Location & Comments

Corner lies on South slope about 250' North of creek. New logged unit to S.E.

Compass Declination 20½

Firm/Agency Roberts Surveying inc.

Address 29 West 29th St. Eugene, Oregon 97405

Party Chief Les Roberts

Notes _____

Witness _____

Surveyor's Seal

