

M 98-19


OREGON CORNER RESTORATION FORM

Section 25 Township 19S Range 9W

County Douglas Date 1-08-85

Corner Designation

East $\frac{1}{4}$ Corner of
Section 25 only

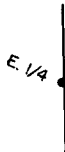

- Condition Report Only
- Not Found
- Renewed
- Unrecorded
- Surveyed In
- Referenced Out

Previous Renewals/Surveys, etc. 1957 G.L.O. Survey by Tillman and Survey M87-78 by Roberts Surveying in 1981.

Monument(s) & Accessories Found: (Condition and Source)


Found 1957 G.L.O. Brass Cap set firmly in ground.

20" Maple, S56W, 27.1' (Scar Vis.), 1957 BT. Rec. S56W, 27.1'

22" Maple, N73 $\frac{1}{2}$ W, 18.3' (Scar Vis.), 1957 BT. Rec. N75W, 18.5'

Monument Detail

Sketch

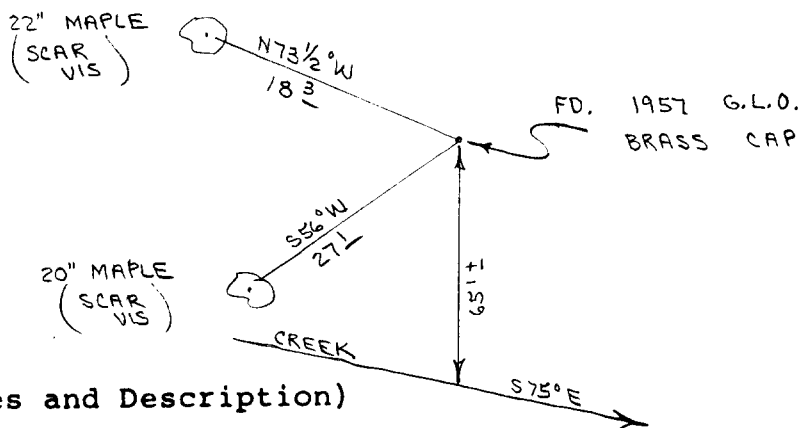

Monument Set (Procedures and Description)

New Accessories

None

Location & Comments

Corner lies on South slope about 65' North of creek. New logged unit to the S.E.

Compass Declination 20 $\frac{1}{2}$

Firm/Agency Roberts Surveying Inc.

Address 29 West 29th St. Eugene, Oregon 97405

Party Chief Les Roberts

Notes _____

Witness _____

Surveyor's Seal

REGISTERED
PROFESSIONAL
LAND SURVEYOR

Les Roberts

OREGON
AUGUST 22, 1975
L. D. ROBERTS
1039