

M 78-19


OREGON CORNER RESTORATION FORM

Section 30 Township 19S Range 8W

County Douglas Date 1-09-85

Corner Designation

South 1/16 Corner  
West Line Sec. 30

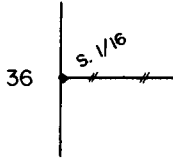

- Condition Report Only
- Not Found
- Renewed
- Unrecorded
- Surveyed In
- Referenced Out

Previous Renewals/Surveys, etc. 1957 G.L.O. Survey by Tillman and Survey M87-78 by Roberts Surveying in 1981.


Monument(s) & Accessories Found: (Condition and Source)

Found 1957 G.L.O. Brass Cap set firmly in ground.

- 7" Downed Fir, N51E, 16.4' (Scribe Vis.), 1957 BT., Rec. N51E, 16.5'
- 13" Fir, S07 1/2 E, 16.4' (Scar Vis.), 1957 BT., Rec. S7 1/4 E, 16.5'
- 36" Fir, S72E, 41.5' (Scar Vis.), 1981 BT., Rec. S72E, 41.5'

Monument Detail

Sketch

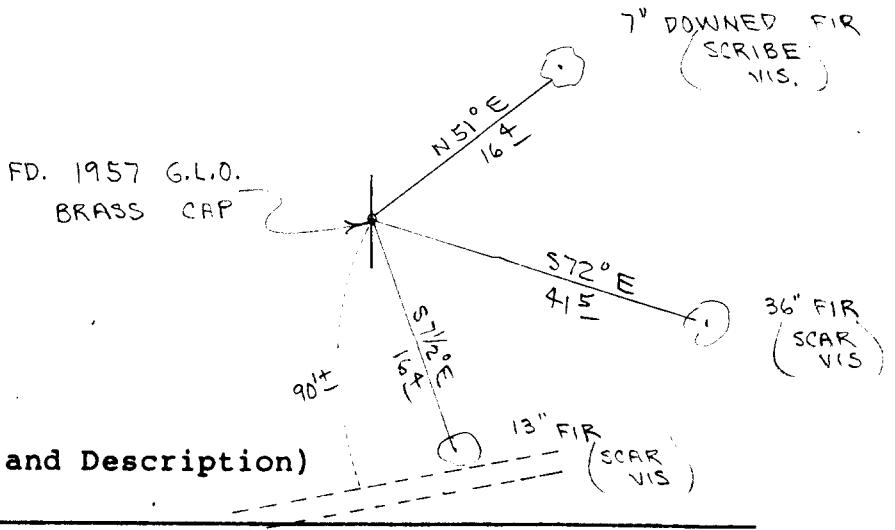

Monument Set (Procedures and Description)

New Accessories

Set metal fence post next to brass cap. Wired land survey monument sign to fence post.

Location & Comments

Corner lies in green timber about 90' North of gravel road. Compass Declination 20 1/2  
 Firm/Agency Roberts Surveying Inc.  
 Address 29 West 29th St. Eugene, Oregon 97405  
 Party Chief Les Roberts  
 Notes \_\_\_\_\_  
 Witness Ted Baker

Surveyor's Seal

REGISTERED  
 PROFESSIONAL  
 LAND SURVEYOR

*Les Roberts*  
 OREGON  
 AUGUST 22, 1975  
 L. D. ROBERTS  
 1039