

M 98-19


OREGON CORNER RESTORATION FORM

Section 36 Township 19S Range 9W

County Douglas Date 1-09-85

Corner Designation

North 1/16 Corner  
East Line Sec. 36

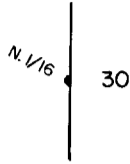

- Condition Report Only
- Not Found
- Renewed
- Unrecorded
- Surveyed In
- Referenced Out

Previous Renewals/Surveys, etc. 1957 G.L.O. Survey by Tillman and Survey M87-78 by Roberts Surveying in 1981.


Monument(s) & Accessories Found: (Condition and Source)

Found 1957 G.L.O. Brass Cap set firmly in ground.

15" Hemlock, S80 3/4W, 23.9' (Scar Vis.), 1957 BT., Rec. S81W, 23.8'  
24" Fir, N64 3/4W, 33.5' (Scar Vis.), 1957 BT., Rec. N64 1/4W, 33.7'

Monument Detail

Sketch

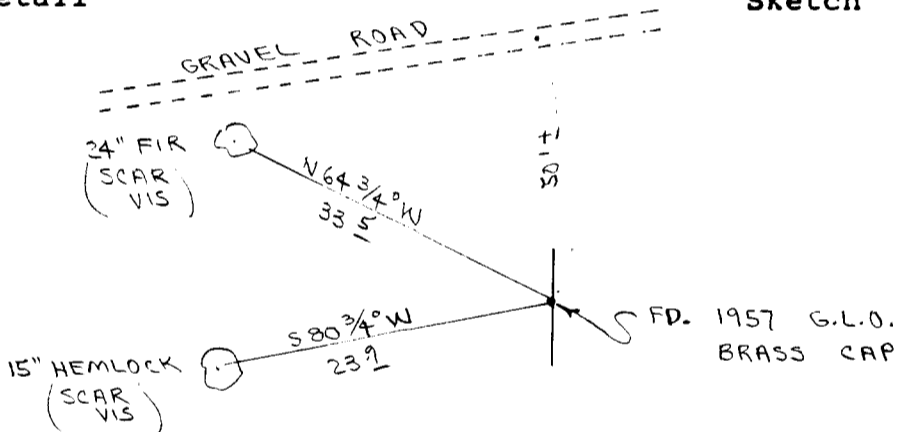

Monument Set (Procedures and Description)

New Accessories

Set metal fence post next to brass cap. Wired land survey monument sign to fence post.

Location & Comments

Corner lies in green timber about 50' South of gravel road. Compass Declination 20 1/2  
Firm/Agency Roberts Surveying Inc.  
Address 29 West 29th St. Eugene, Oregon 97405  
Party Chief Les Roberts  
Notes \_\_\_\_\_  
Witness Ted Baker

Surveyor's Seal

