

M 98-19

OREGON CORNER RESTORATION FORM

Section 30 Township 19S Range 8W

County Douglas Date 1-17-85

Corner Designation



C.E. 1/16 Corner
Section 30

- Condition Report Only
- Not Found
- Renewed
- Unrecorded
- Surveyed In
- Referenced Out

Previous Renewals/Surveys, etc. None

Monument(s) & Accessories Found: (Condition and Source)

Monument Detail

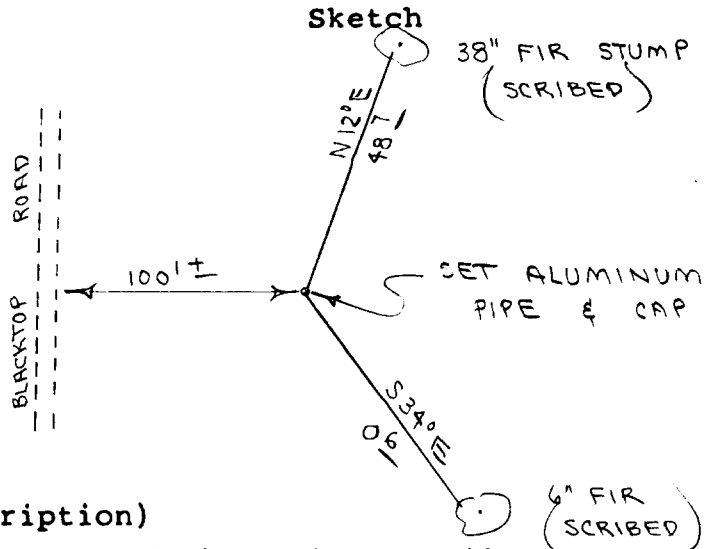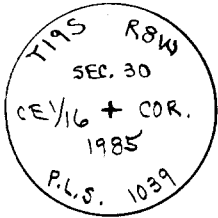

Monument Set (Procedures and Description)

Set 2 1/2" x 30" Aluminum pipe and cap. Buried purple magnetic marker under aluminum pipe. See filed survey in Section 30.

New Accessories

6" Fir, S34E, 0.6' (Painted/Scribed/Aluminum washer)

38" Fir Stump, N12E, 48.7' (Painted/Scribed/Aluminum washer)

Set metal fence post beside aluminum pipe. Wired land survey monument sign to fence post.

Location & Comments

Corner lies on West slope about 100' East of blacktop road. Compass Declination 20 1/2

Corner is in stand of 15 year old reprod. Firm/Agency Roberts Surveying Inc. Address 29 West 29th St. Eugene, Oregon 97405

Party Chief Ted Baker

Notes _____

Witness Stu Duce

Surveyor's Seal

