

M 98-19

OREGON CORNER RESTORATION FORM

Section 30 Township 19S Range 8W

County Douglas Date 1-09-85

Corner Designation

North 1/16 Corner
West Line Sec. 30



- Condition Report Only
- Not Found
- Renewed
- Unrecorded
- Surveyed In
- Referenced Out


Previous Renewals/Surveys, etc. Survey M87-78 by Roberts
Surveying in 1981.

Monument(s) & Accessories Found: (Condition and Source)

Corner, Found 1 1/2" iron pipe with brass cap set firmly in ground.
26" Fir Stump, S11E, 35.4' (Scribe Vis.), 1981 BT. Rec. S11E, 35.4'
28" Fir Stump, N49E, 26.0' (Scribe Vis.), 1981 BT. Rec. N49E, 26.0'

Monument Detail

Sketch

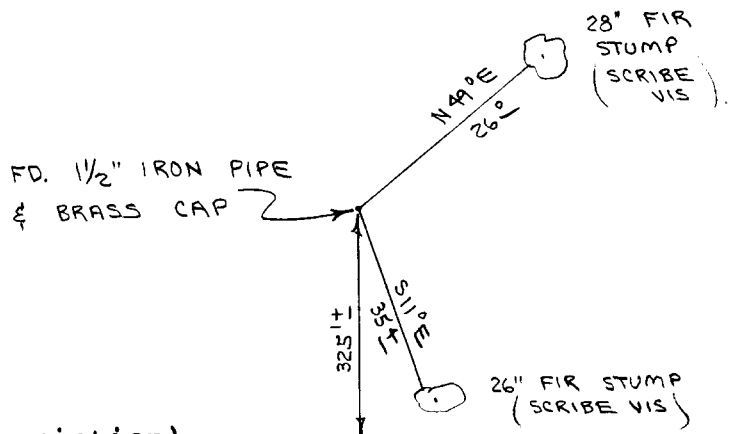

Monument Set (Procedures and Description)

New Accessories

None

Location & Comments

Corner lies on top
of high flat ridge,
about 325' North of
gravel road. New
logged unit lies to
East.

Compass Declination 20 1/2
 Firm/Agency Roberts
Surveying Inc.
 Address 29 West 29th St.
Eugene, Oregon 97405
 Party Chief Les Roberts
 Notes _____
 Witness _____

Surveyor's Seal

