

M96-61 A+B

FILED  
RECEIVED *jk*

JUN 5 1984


OREGON CORNER RESTORATION FORM

Section 27 Township 21S Range 11W

COUNTY SURVEYOR  
DOUGLAS COUNTY, ORE.

County Douglas Date 4-16-84

Corner Designation

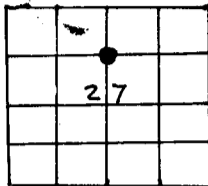

- Condition Report Only
- Not Found
- Renewed
- Unrecorded
- Surveyed In
- Referenced Out

Previous Renewals/Surveys, etc.

NONE


Monument(s) & Accessories Found: (Condition and Source)

NONE

Monument Detail

Sketch

Set 3" alum. cap in 2 1/2" x 30" alum. pipe with flared base, rockmound.

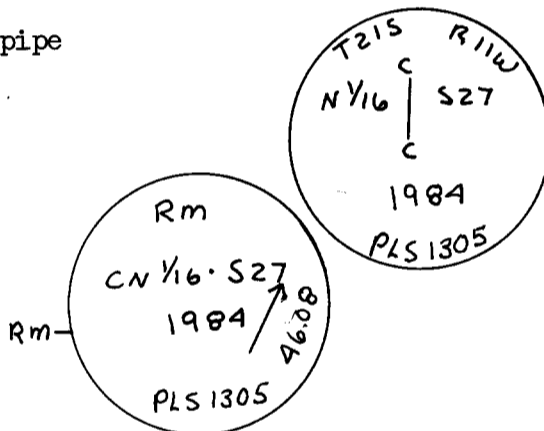

Monument Set (Procedures and Description)

Set by survey and subdivision of Section 26.

New Accessories

12" D. Fir bears S 50° W 22.9 ft., scribed CN 1/16 S27 BT

Set R.M.- 3" Alum. cap on 2 1/2" x 30" alum. pipe bears S 23° 32' 17" W 46.08 ft.

Location & Comments

Surveyor's Seal

Set from survey for  
U.S. Forest Service

Compass Declination 19° 50' E

Firm/Agency

Jackson & Prochnau, Inc.

Address P.O. Box 177

Albany, Ore. 97321

Party Chief K. Kendall

Notes

Witness Larry Griensewic

REGISTERED  
PROFESSIONAL  
LAND SURVEYOR

*James W. Prochnau*  
OREGON  
SEPTEMBER 21, 1977  
JAMES W. PROCHNAU  
1305