

M 96-61 A+B

FILED
RECEIVED *jh*

OREGON CORNER RESTORATION FORM


JUN 5 1984

Section 27 Township 21S Range 11W

COUNTY SURVEYOR
DOUGLAS COUNTY, ORE.

County Douglas Date 4-16-84

Corner Designation

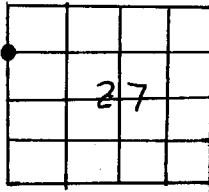

- Condition Report Only
- Not Found
- Renewed
- Unrecorded
- Surveyed In
- Referenced Out

Previous Renewals/Surveys, etc.

1960 BLM

Monument(s) & Accessories Found: (Condition and Source)


Fd. 3 1/2" brass cap in 1" G.I.P. set by BLM.

Fd. BLM BT's: 14" D. Fir bears N 33° W 4.0 ft. (rec. N 45° W) healed face.

12" D. Fir stump bears N 55° W 14.4 ft. (rec. N 54 1/2° E 20 lks.) healed face.

Monument Detail

Sketch

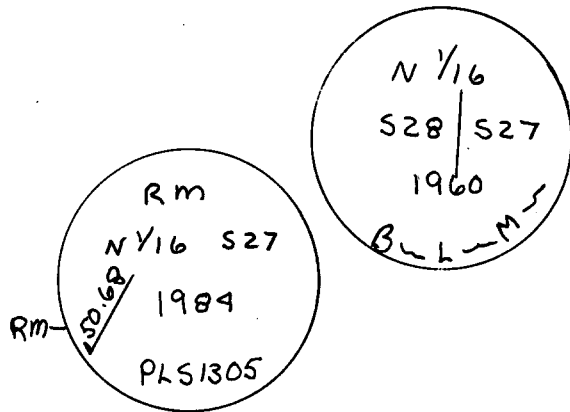

Monument Set (Procedures and Description)

New Accessories

Set R.M.- 2" alum. cap on 5/8" x 24" iron rod bears N 48° 19' 07" E 50.68 ft.

Location & Comments

Surveyor's Seal

Set from survey for Compass Declination 19 50' E

U.S. Forest Service

Firm/Agency

Jackson & Prochnau, Inc.

Address P.O. Box 177

Albany, Ore. 97321

Party Chief K. Kendall

Notes

Witness Larry Griensewic

REGISTERED
PROFESSIONAL
LAND SURVEYOR

James W Prochnau

OREGON
SEPTEMBER 21, 1977
JAMES W. PROCHNAU
1305