

M 96-62

FILED
RECEIVED BS

OREGON CORNER RESTORATION FORM


JUN 5 1984

Section 26 Township 21S Range 11W

COUNTY SURVEYOR
DOUGLAS COUNTY, ORE.

County Douglas Date 4-16-84

Corner Designation

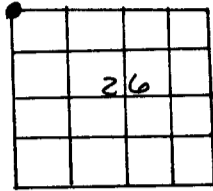

- Condition Report Only
- Not Found
- Renewed
- Unrecorded
- Surveyed In
- Referenced Out

Previous Renewals/Surveys, etc. _____

Original GLO 1891 Thiel, BLM 1960; Stuntzner 1980 M 84-51

Monument(s) & Accessories Found: (Condition and Source)

Fd. 3" brass cap in 2 1/2" G.I. pipe set by BLM.


Fd. BLM BT: 1 1/4" D. Fir bears N 13° W, 17.2 ft., healed face.

Fd. Stuntzner BT's: 10" D. Fir bears N 22° E 21.7 ft., healed face.

26" Maple bears S 48° E 110.0 ft.

Monument Detail

Sketch

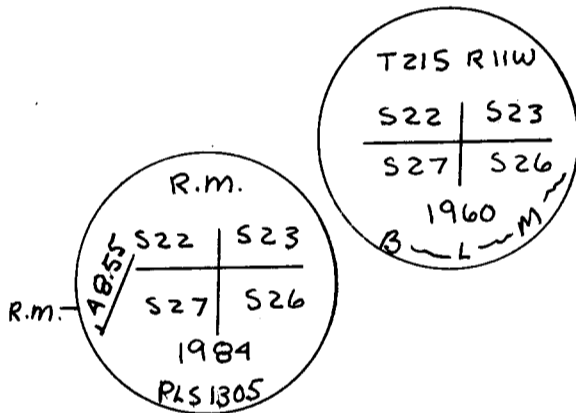

Monument Set (Procedures and Description)

New Accessories

Set R.M.- 3" alum. cap on 2 1/2" x 30" alum. pipe bears N 55° 56' 51" E, 48.55 ft.

Location & Comments

Set from survey for
U.S. Forest Service

Compass Declination 19° 50' E
Firm/Agency _____

Jackson & prochnau, Inc.
Address P.O. Box 177

Albany, Ore. 97321
Party Chief K. Kendall

Notes _____

Witness Larry Griensewic

Surveyor's Seal

REGISTERED
PROFESSIONAL
LAND SURVEYOR

James W. Prochnau

OREGON
SEPTEMBER 21, 1977
JAMES W. PROCHNAU
1305

#171