

M 96-63 A & B

FILED
RECEIVED *bl*

OREGON CORNER RESTORATION FORM


JUN 6 1984

Section 28 Township 21S Range 11W

COUNTY SURVEYOR
DOUGLAS COUNTY, ORE.

County Douglas Date 4-16-84

Corner Designation

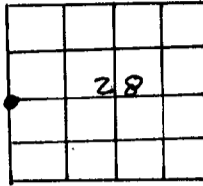

- Condition Report Only
- Not Found
- Renewed
- Unrecorded
- Surveyed In
- Referenced Out

Previous Renewals/Surveys, etc.


Original GLO 1891 Thiel; 1967 Haines M 34-30; 1979 Hintz M 78-74

Monument(s) & Accessories Found: (Condition and Source)

- Fd. remains of orig. cor. tree-44" rotten fir snag.
- Fd. 2 1/2" brass cap in 1 1/4" iron pipe for W.C. set by Hintz 4.3 ft. East of corner.
- Fd. 3/4" G.I.P. 0.3 ft. West of cap set by Haines, LS 239.
- Fd. orig. Bt: 50" D. Fir stump bears S 3° E 324.0 ft. (rec. 510 lks.)
- Fd. Hintz BT's: 13" D. Fir bears N 48° E 13.0 ft., (rec. N 52° E 12.6 ft.) vis. scribe
- 24" D. Fir bears S 9° W 16.5 ft., (rec 16.6 ft.) vis. scribe

Monument Detail

Sketch

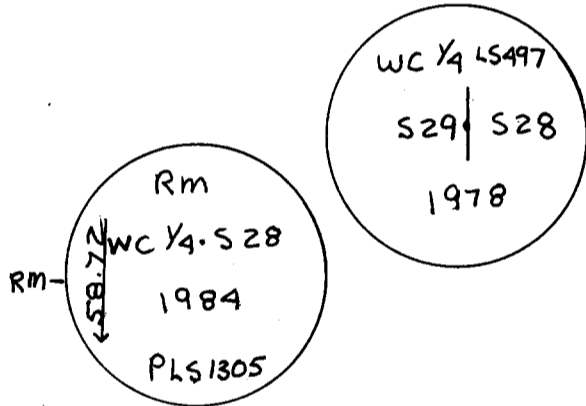

Monument Set (Procedures and Description)

New Accessories

Set R.M.- 3" alum. cap in 2 1/2" x 30" alum. pipe bears N 2° 16' 35" E 58.72 Ft.

Location & Comments

Set from survey for U.S. FOREST SERVICE Compass Declination 19° 50' E
 Firm/Agency Jackson & Prochnau, Inc.
 Address P.O. Box 177
Albany, Ore. 97321
 Party Chief K. Kendall
 Notes _____
 Witness Larry Griensewic

Surveyor's Seal

REGISTERED
PROFESSIONAL
LAND SURVEYOR

James W. Prochnau

OREGON
SEPTEMBER 21, 1977
JAMES W. PROCHNAU
1305