

M 96-63 A-B

FILED
RECEIVED *RL*

OREGON CORNER RESTORATION FORM


JUN 6 1984

Section 28 Township 21S Range 11W

COUNTY SURVEYOR
DOUGLAS COUNTY, ORE.

County Douglas Date 4-16-84

Corner Designation

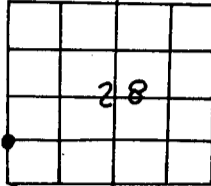

- Condition Report Only
- Not Found
 - Renewed
 - Unrecorded
 - Surveyed In
 - Referenced Out

Previous Renewals/Surveys, etc.

1979 Hintz CS# 78-74


Monument(s) & Accessories Found: (Condition and Source)

NONE

Monument Detail

Set 3" alum. cap in 2 1/2" x 30" alum. pipe with flared base.

Sketch

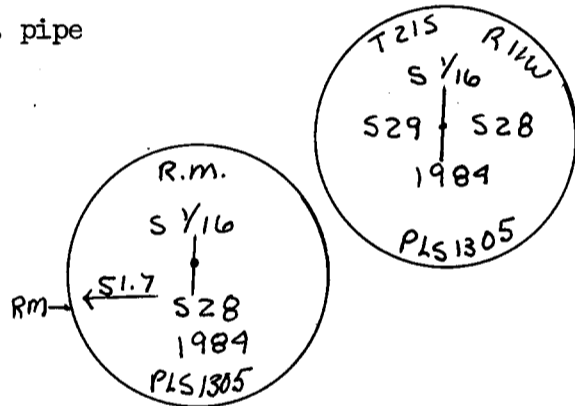

Monument Set (Procedures and Description)

Set by survey and subdivision of Section 28.

New Accessories

56" Hemlock bears N 34° W 34.6 ft., scribed S 1/16 S29 BT

16" Maple bears S 73° E 23.3 ft., scribed S 1/16 S28 BT

Set R.M. - 2 1/4" brass cap in 1"x30" I.R. bears N 84° 34' 00" E 51.7 ft.

Location & Comments

Set from survey for

U.S. Forest Service

Compass Declination 19° 50' E

Firm/Agency

Jackson & Prochnau, Inc.

Address P.O. Box 177

Albany, Ore. 97321

Party Chief K. Kendall

Notes

Witness Larry Griensewic

Surveyor's Seal

REGISTERED
PROFESSIONAL
LAND SURVEYOR

James W. Prochnau

OREGON
SEPTEMBER 21, 1977
JAMES W. PROCHNAU
1305

C.S. File No. 58/294-4c