

M 96-63 A & B

FILED
RECEIVED *BS*

OREGON CORNER RESTORATION FORM


JUN 6 1984

Section 28 Township 21S Range 11W

COUNTY SURVEYOR
DOUGLAS COUNTY, ORE.

County Douglas Date 4-16-84

Corner Designation

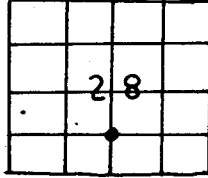

- Condition Report Only
- Not Found
- Renewed
- Unrecorded
- Surveyed In
- Referenced Out

Previous Renewals/Surveys, etc.
NONE


Monument(s) & Accessories Found: (Condition and Source)

NONE

Monument Detail

Set 2" alum. cap on 1/2" x 18" iron rod. Rock mound.

Sketch

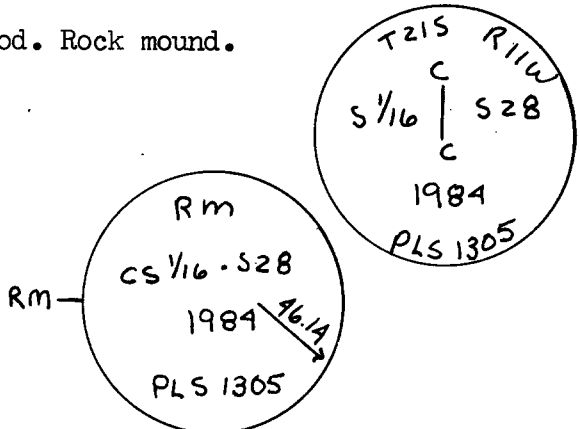

Monument Set (Procedures and Description)

Set by survey and subdivision of Section 28.

New Accessories

24" D. Fir bears N 6° E 53.8 ft., scribed CS 1/16 S28 BT

18" D. Fir bears S 74° E 18.3 ft., scribed 1/16 S28 BT

Set R.M. - 3" alum. cap on a 2 1/2" x 30" alum. pipe bears N 80° 16' 57" W 46.14 ft.

Location & Comments

Set from survey for
U. S. Forest Service

Compass Declination 19° 50' E
 Firm/Agency Jackson & Prochnau, Inc.
 Address P.O. Box 177
Albany, Ore. 97321
 Party Chief K. Kendall
 Notes _____
 Witness Larry griensewic

Surveyor's Seal

