

M 96-63 A & B

FILED
RECEIVED *W*

OREGON CORNER RESTORATION FORM


JUN 6 1984

Section 28 Township 21S Range 11W

COUNTY SURVEYOR
DOUGLAS COUNTY, ORE.

County Douglas Date 4-16-84

Corner Designation

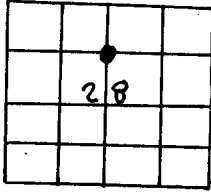

- Condition Report Only
- Not Found
- Renewed
- Unrecorded
- Surveyed In
- Referenced Out

Previous Renewals/Surveys, etc. NONE


Monument(s) & Accessories Found: (Condition and Source)

NONE

Monument Detail

Set 2" alum. cap on a 1/2" x 24" I.R., rockmound.

Sketch

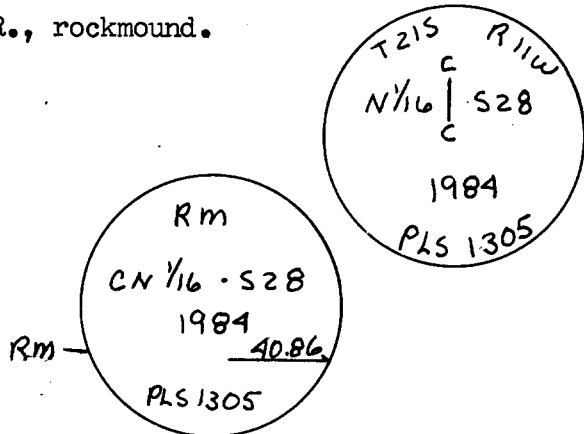

Monument Set (Procedures and Description)

Set by survey and subdivision of Section 28

New Accessories

22" D. Fir bears S 5° E 20.6 ft., scribed CN 1/16 S28 BT

Set R.M.- 3" alum. cap on a 2 1/2" x 30" alum. pipe bears S 88° 46' 36" 40.86 ft.

Location & Comments

Set from survey for U.S. Forest Service Compass Declination 19° 50' E
 Firm/Agency Jackson & Prochnau, Inc.
 Address P.O. Box 177
Albany, Ore. 97321
 Party Chief K. Kendall
 Notes _____
 Witness Larry Griensewic

Surveyor's Seal

REGISTERED
PROFESSIONAL
LAND SURVEYOR

James W. Prochnau

OREGON
SEPTEMBER 21, 1977
JAMES W. PROCHNAU
1305