

M 96-63 AEB

FILED
RECEIVED *ll*

OREGON CORNER RESTORATION FORM


JUN 6 1984

Section 29 Township 21S Range 11W

COUNTY SURVEYOR
DOUGLAS COUNTY, ORE.

County Douglas Date 4-17-84

Corner Designation

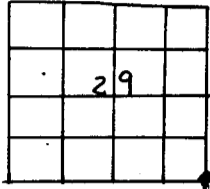

- Condition Report Only
- Not Found
- Renewed
- Unrecorded
- Surveyed In
- Referenced Out

Previous Renewals/Surveys, etc.

Original GIO 1891 Thiel; 1959 Hootman M 15-23; 1979 Hintz M 78-74; 1979 Stuntzner M 78-79


Monument(s) & Accessories Found: (Condition and Source)

- Fd. 5/8" iron rod by Stuntzner LS 1342, in 1979.
- Fd. orig. BT: 36" Cedar bears N 10° E, 23.1 ft.
- Fd. Stuntzner BT: 42" Hemlock bears N 14° W 55.2 ft. (rec. N 16° W) vis. scribe

Monument Detail

Set 3" alum. cap on 2 1/2" x 30" al pipe with flared base, rockmound.

Sketch

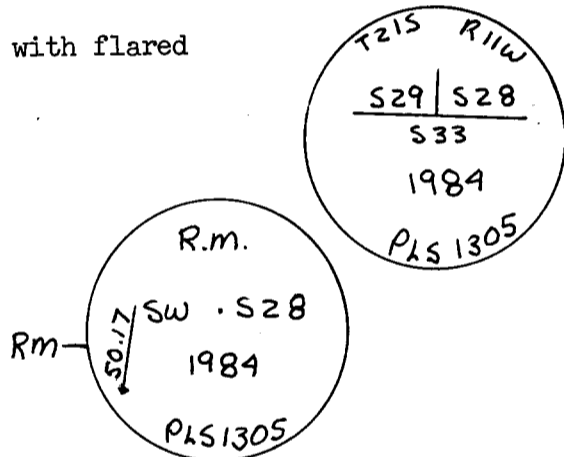

Monument Set (Procedures and Description)

New Accessories

- 15" Hemlock bears N 70° W, 63.5 ft., scribed T21S R11W S29 BT
- Set R.M.- 2" alum. cap on 1/2" x 24" iron rod bears N 17° 12' 51" E, 50.17 ft.

Location & Comments

Set from survey for U.S. Forest Service Compass Declination 19° 50' E
 Firm/Agency Jackson & Prochnau, Inc.
 Address P.O. Box 177
Albany, Ore. 97321
 Party Chief K. Kendall
 Notes _____
 Witness Larry Griensewic

Surveyor's Seal

REGISTERED
PROFESSIONAL
LAND SURVEYOR

James W. Prochnau

OREGON
SEPTEMBER 21, 1977
JAMES W. PROCHNAU
1305

⑩ #188

C.S. File No. 58/294-4