

M 96-64 A & B

FILED RECEIVED BS

OREGON CORNER RESTORATION FORM


JUN 6 1984

Section 33 Township 21S Range 11W

COUNTY SURVEYOR DOUGLAS COUNTY, ORE.

County Douglas Date 4-17-84

Corner Designation

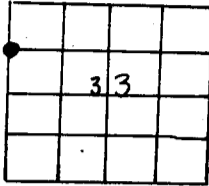

- Condition Report Only
- Not Found
- Renewed
- Unrecorded
- Surveyed In
- Referenced Out

Previous Renewals/Surveys, etc.

1979 Stuntzner M 78-79

Monument(s) & Accessories Found: (Condition and Source)


Fd. 5/8" iron rod set by Stuntzner LS 1342, bears S 3° W 0.56 ft. from true position.

Fd. Stuntzner BT's to iron rod: 30" D. Fir bears N 8° W 8.7 ft., vis. scribe 16" W.R. Cedar bears S 35° E 16.0 ft., vis. scribe

Monument Detail

Set 2" alum. cap in 1 1/2" x 1/2" iron rod in sandstone.

Sketch

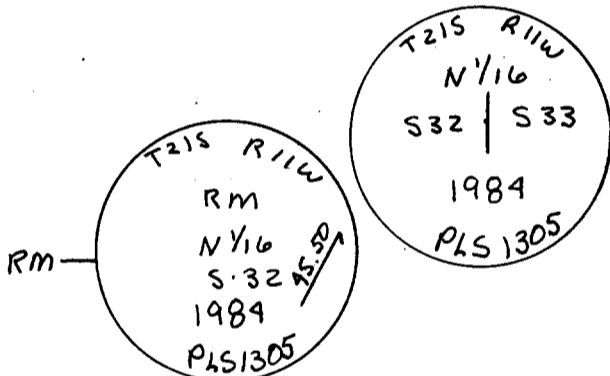

Monument Set (Procedures and Description)

Set by survey and subdivision of Section 33

New Accessories

16" R. Cedar bears S 37° E 16.2 ft., scribed N 1/16 S33 BT

Set R.M.- 2" alum. cap on 1 1/2" x 12" iron rod bears S 40° 43' 35" W 45.50 ft.

Location & Comments

Set from survey for U.S. Forest Service

Compass Declination 19° 50' E

Firm/Agency

Jackson & Prochnau, Inc.

Address P.O. Box 177

Albany, Ore. 97321

Party Chief K. Kendall

Notes

Witness Larry Griensewic

Surveyor's Seal

REGISTERED PROFESSIONAL LAND SURVEYOR

James W. Prochnau

OREGON SEPTEMBER 21, 1977 JAMES W. PROCHNAU 1305