

M 96-64 AEB

FILED
RECEIVED BS

OREGON CORNER RESTORATION FORM


JUN 6 1984

Section 33 Township 21S Range 11W

COUNTY SURVEYOR
DOUGLAS COUNTY, ORE.

County Douglas Date 4-16-84

Corner Designation

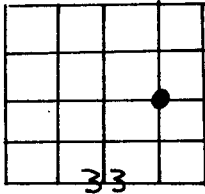

- Condition Report Only
- Not Found
- Renewed
- Unrecorded
- Surveyed In
- Referenced Out

Previous Renewals/Surveys, etc.

NONE


Monument(s) & Accessories Found: (Condition and Source)

NONE

Monument Detail

Set 2" alum. cap on 1/2" x 8" rebar in rock.

Sketch

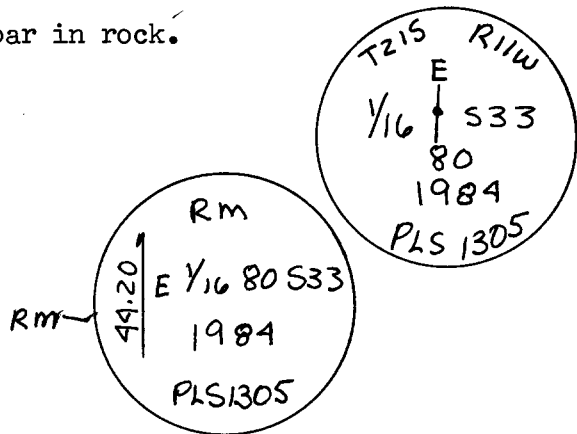

Monument Set (Procedures and Description)

Set from survey and subdivision of Section 33

New Accessories

22" D. Fir bears N 13° W 7.9 ft., scribed E 1/16 80 S33 BT

Set R.M.- 3" alum. cap in 2 1/2" x 30" alu. pipe bears S11°28'35" E
44.20 ft.,

Location & Comments

Set from survey for
U.S. Forest Service

Compass Declination 19°50'E

Firm/Agency

Jackson & Prochnau, Inc.

Address P.O. Box 177

Albany, Ore. 97321

Party Chief K. Kendall

Notes

Witness Larry Griensewic

Surveyor's Seal

REGISTERED
PROFESSIONAL
LAND SURVEYOR

James W. Prochnau

OREGON
SEPTEMBER 21, 1977
JAMES W. PROCHNAU
1305

C.S. File No. 58/224-5h