

M 96-65 A&B

FILED  
RECEIVED *RS*

OREGON CORNER RESTORATION FORM


JUN 6 1984

Section 34 Township 21S Range 11W

COUNTY SURVEYOR  
DOUGLAS COUNTY, ORE.

County Douglas Date 4-16-84

Corner Designation

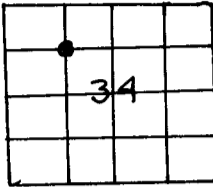

- Condition Report Only
- Not Found
- Renewed
- Unrecorded
- Surveyed In
- Referenced Out

Previous Renewals/Surveys, etc. NONE


Monument(s) & Accessories Found: (Condition and Source)

NONE

Monument Detail

Set 3" alum. cap in 2 1/2" x 30" alum. pipe with flared base.

Sketch

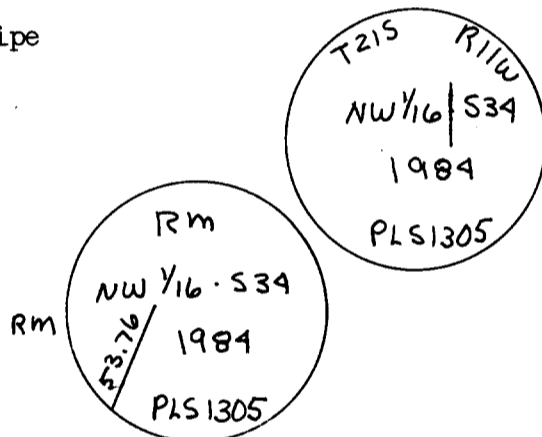

Monument Set (Procedures and Description)

Set from survey and subdivision of Section 34.

New Accessories

11" D. Fir bears S 65° E 62.8 ft., scribed NW 1/16 S34 BT

Set R.M.- 3" alum. cap on 2 1/2" x 30" alum. pipe bears S 4° 39' 59" W 53.76 ft.

Location & Comments

Set from survey for U.S. Forest Service

Compass Declination 19° 50' E

Firm/Agency Jackson & Prochnau, Inc.

Address P.O. Box 177 Albany, Ore. 97321

Party Chief K. Kendall

Notes \_\_\_\_\_

Witness Larry Griensewic

Surveyor's Seal

REGISTERED  
PROFESSIONAL  
LAND SURVEYOR

*James W. Prochnau*  
OREGON  
SEPTEMBER 21, 1977  
JAMES W. PROCHNAU  
1305