

M 96-65 A & B

FILED  
RECEIVED *BJ*

JUN 6 1984


OREGON CORNER RESTORATION FORM

Section 34 Township 21S Range 11W

COUNTY SURVEYOR  
DOUGLAS COUNTY, ORE.

County Douglas Date 4-16-84

Corner Designation

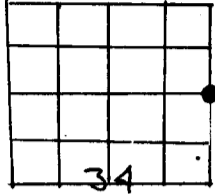

- Condition Report Only
- Not Found
- Renewed
- Unrecorded
- Surveyed In
- Referenced Out

Previous Renewals/Surveys, etc. NONE


Monument(s) & Accessories Found: (Condition and Source)

NONE

Monument Detail

Set 3" alum. cap in 2 1/2" x 30" alum. pipe with flared base.

Sketch

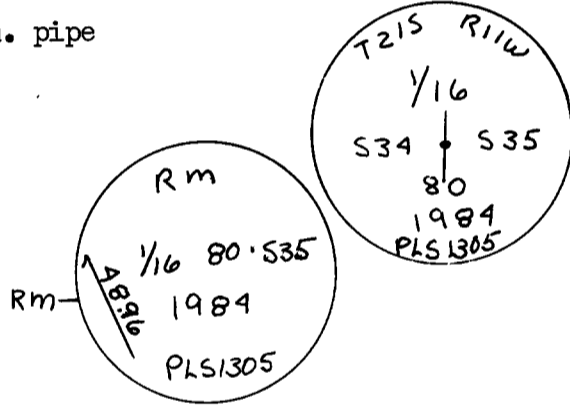

Monument Set (Procedures and Description)

Set from survey and subdivision of Section 34.

New Accessories

5" D. Fir bears N 04° E 12.1 ft., bark scribed X BT  
Set R.M.-3" alum. cap on 2 1/2" x 30" alum. pipe bears S 57° 28' 38" E 48.96 ft.

Location & Comments

Set from survey for U.S. Forest Service Compass Declination 19° 50' E  
Firm/Agency Jackson & Prochnau, Inc.  
Address P.O. Box 177  
Albany, Ore. 97321  
Party Chief K. Kendall  
Notes \_\_\_\_\_  
Witness Larry Griensewic

Surveyor's Seal

REGISTERED  
PROFESSIONAL  
LAND SURVEYOR

*James W. Prochnau*

OREGON  
SEPTEMBER 21, 1977  
JAMES W. PROCHNAU  
1305