

M 96-65 A & B

FILED
RECEIVED *BS*

OREGON CORNER RESTORATION FORM


JUN 6 1984

Section 34 Township 21S Range 11W

COUNTY SURVEYOR
DOUGLAS COUNTY, ORE.

County Douglas Date 4-16-84

Corner Designation

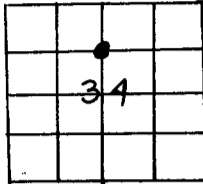

- Condition Report Only
- Not Found
- Renewed
- Unrecorded
- Surveyed In
- Referenced Out

Previous Renewals/Surveys, etc. NONE


Monument(s) & Accessories Found: (Condition and Source)

NONE

Monument Detail

Set 3" alum. cap in 2 1/2" x 30" alum. pipe with flared base, rockmound.

Sketch

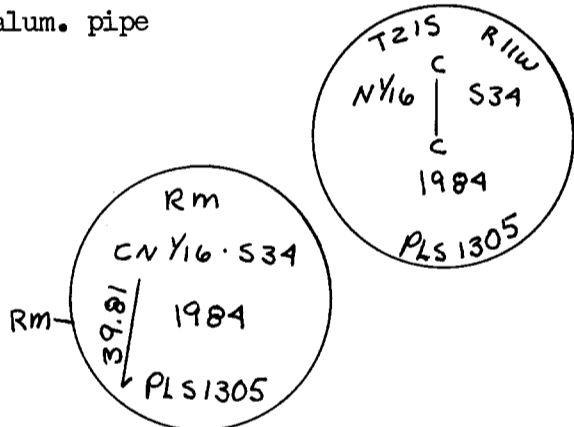

Monument Set (Procedures and Description)

Set from survey and subdivision of Section 34.

New Accessories

16" D. Fir bears S 74° W 37.3 ft., scribed CN 1/16 S34 BT

Set R.M.- 3" alum. cap in 2 1/2" x 30" alum. pipe bears N 19° 24' 34" E 39.81 ft.

Location & Comments

Surveyor's Seal

Set from survey for U.S. Forest Service Compass Declination 19° 50' E

Firm/Agency Jackson & Prochnau, Inc.

Address P.O. Box 177
Albany, Ore. 97321

Party Chief K. Kendall

Notes _____

Witness Larry Griensewic