

M 96-65 A & B

FILED
RECEIVED *BS*

OREGON CORNER RESTORATION FORM


JUN 6 1984

Section 34 Township 21S Range 11W

COUNTY SURVEYOR
DOUGLAS COUNTY, ORE.

County Douglas Date 4-16-84

Corner Designation

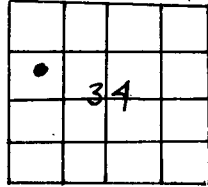

- Condition Report Only
- Not Found
- Renewed
- Unrecorded
- Surveyed In
- Referenced Out

Previous Renewals/Surveys, etc. _____

NONE


Monument(s) & Accessories Found: (Condition and Source)

NONE

Monument Detail

Sketch

Set 3" alum. cap in 2 1/2" x 30" alum. pipe with flared base.

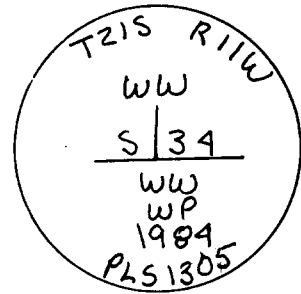

Monument Set (Procedures and Description)

Set from survey and subdivision of Section 34 on North bank Umpqua River.

New Accessories

19" D. Fir bears S 65° E 19.5 ft., scribed XBT

22" D. Fir bears S 57° W, 13.8 ft., scribed XBT

Location & Comments

Surveyor's Seal

Set from survey for _____ Compass Declination 19°50'E

U.S. Forest Service _____ Firm/Agency _____

Jackson & Prochnau, Inc.

Address P.O. Box 177

Albany, Ore. 97321

Party Chief K. Kendall

Notes _____

Witness Larry Griensewic

REGISTERED
PROFESSIONAL
LAND SURVEYOR

James W. Prochnau

OREGON
SEPTEMBER 21, 1977
JAMES W. PROCHNAU
1305