

FILED  
RECEIVED

MAR 15 1985

OREGON CORNER RESTORATION FORM

Section 4 Township 32 S Range 5 W

County Douglas Date 3-13-95

COUNTY SURVEYOR  
DOUGLAS COUNTY, ORE.

Corner Designation

1/4 cor 5/4

- Condition Report Only
- Not Found
- Renewed
- Unrecorded
- Surveyed In
- Referenced Out

Previous Renewals/Surveys, etc.

1962 Cadastral resurvey

Monument(s) & Accessories Found: (Condition and Source)

BC on Iron Pipe ok.


8" Fir N88 1/2 W 119 OBT rotten snag scribe visible

22" Fir N65 W 55 1/2 Resurvey BT. Stamp.

17 W Fir N18 E 58 1/2 " " good Scat.

Monument Detail

Sketch

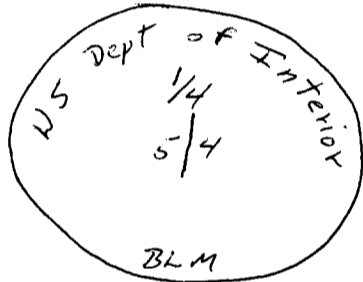

Monument Set (Procedures and Description)

\_\_\_\_\_  
\_\_\_\_\_  
\_\_\_\_\_

New Accessories

10" W Fir S76 W 17° scribed. "1/4 S 5 BT"

Location & Comments

Cor is 150 West of road running N+S. Compass Declination 20°

Firm/Agency \_\_\_\_\_

Roseburg Lbr. Co.

Address P.O. Box 1088

Roseburg OR 97470

Party Chief H.W. Johnstone

Notes \_\_\_\_\_

Witness \_\_\_\_\_

Surveyor's Seal

REGISTERED  
PROFESSIONAL  
LAND SURVEYOR

Howard W. Johnstone

OREGON  
MAY 13, 1960  
HOWARD W. JOHNSTONE  
498

U.S. File No. 58/226-2

#216 ✓