

FILED  
RECEIVED

OCT 17 1984

OREGON CORNER RESTORATION FORM

Section 16 Township 30S Range 2W

County DOUGLAS Date 9-20-84

COUNTY SURVEYOR  
DOUGLAS COUNTY, ORE.

Corner Designation

- Condition Report Only
- Not Found
- Renewed
- Unrecorded
- Surveyed In
- Referenced Out

Previous Renewals/Surveys, etc. #167


Monument(s) & Accessories Found: (Condition and Source)

- IPBC & STONE GOOD
- FIR 36" N25E 25' SNAG & ROTTEN
- FIR 32" S72E 12' SNAG & ROTTEN

Monument Detail

Sketch

20 | 16  
---|  
21

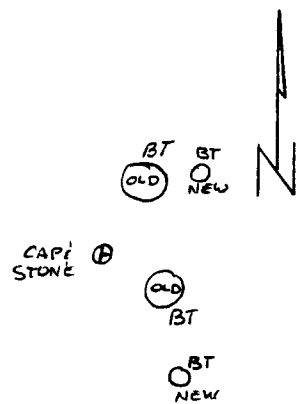

Monument Set (Procedures and Description)

New Accessories

- W. FIR 12" N31E 37' SCRIBED W/SEC & BT
- CEDAR 6" S24E 38' " " "

Location & Comments

Surveyor's Seal

Compass Declination \_\_\_\_\_  
 Firm/Agency Roseburg  
Lumber Co.  
 Address P.O. Box 1088  
Roseburg, OR  
 Party Chief Floyd White  
 Notes Bill Olson  
 Witness Mark Day

REGISTERED  
PROFESSIONAL  
LAND SURVEYOR

*Howard W. Johnstone*

OREGON  
MAY 13, 1960  
HOWARD W. JOHNSTONE  
498

#251X

C.S. File No. 58/296-5