

679-330  
A-321

FILED  
RECEIVED

OREGON CORNER RESTORATION FORM

JUL 9 1984

Section 16/15/21/22 Township 29S Range 7W

County Douglas Date 6/29/84

COUNTY SURVEYOR  
DOUGLAS COUNTY, ORE.

Corner Designation

16/15/  
21/22

- Condition Report Only
- Not Found
- Renewed
- Unrecorded
- Surveyed In
- Referenced Out

Previous Renewals/Surveys, etc.

1957 and 1966 CAD Resurveys.

Monument(s) & Accessories Found: (Condition and Source)

7" D.F. N67W 7.3 good condition 1966 CAD

59" D.F. N58E 48.8 Now a stump 1957 + 1966 CAD


24" D.F. S51E 53.5 good condition 1966 CAD

33" D.F. S24W 32.3 " " " "

Monument Detail

Sketch

Brass Cap + Iron Pipe

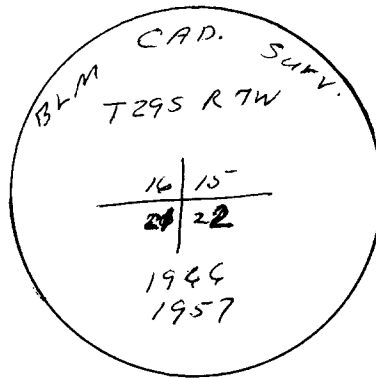

Monument Set (Procedures and Description)

\_\_\_\_\_  
\_\_\_\_\_  
\_\_\_\_\_

New Accessories

20" D.F. S84E 74.7 scribed: T29S R7W S22 BT.

NW of Section 15 has been recently clear cut. No remaining

trees suitable for B.T.s.

Location & Comments

Surveyor's Seal

Cor is about 300 Compass Declination 21°

West of road at corner Firm/Agency Roseburg Lbr. Co.

of recent clear cut.

Address P.O. Box 1088

Roseburg, OR 97470

Party Chief Howard W. Johnstone

Notes

Witness

REGISTERED  
PROFESSIONAL  
LAND SURVEYOR

OREGON  
MAY 13, 1960  
HOWARD W. JOHNSTONE  
498

*Howard W. Johnstone*

*ok Jim*

C.S. File No. 58/296-7 C

2784