


3/11/76

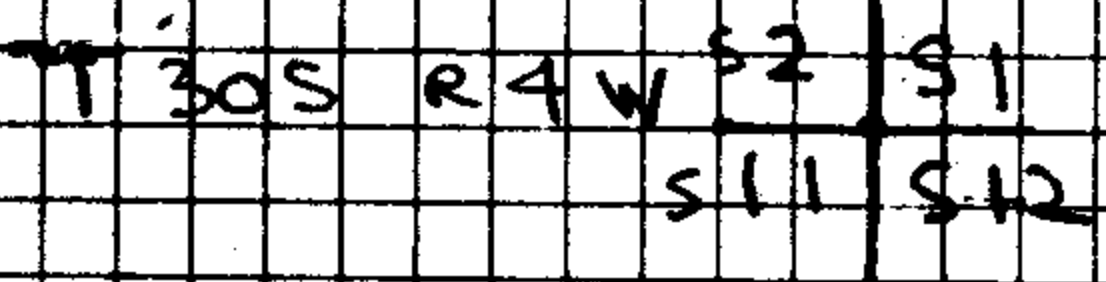

FOUND:

8" R. FIR NOW 16" THAT BEARS NISE AND 91.2' DISTANCE. GOOD SCAR AND TREE IS ALIVE & WELL. SEE RENEWAL #108

16" W. FIR STUMP BEARS NS8°W AND 41.6' DISTANCE. NO SCRIBING VISIBLE BUT FIT WELL FOR BEARING AND DIST. SEE RENEWAL #108


12" R. FIR NOW 19" BEARS S65°E AND 25.3' DISTANCE. SHOWS GOOD SCAR & IS ALIVE & WELL. SEE RENEWAL #108

36" R. FIR STUMP BEARS S6°E AND 36.7' DISTANCE. NO SCRIBING VISIBLE BUT FIT FOR BEARING AND DISTANCE STUMP IS DECAYED & VERY ROTTEN.

FOUND NO TRACE OF ANY OTHER MONUMENTS. AT THE CORNER POINT WE SET A 1.30" IRON PIPE WITH BRASS CAP STAMPED

DOUGLAS CO. SURVEYOR

T30S RAW.

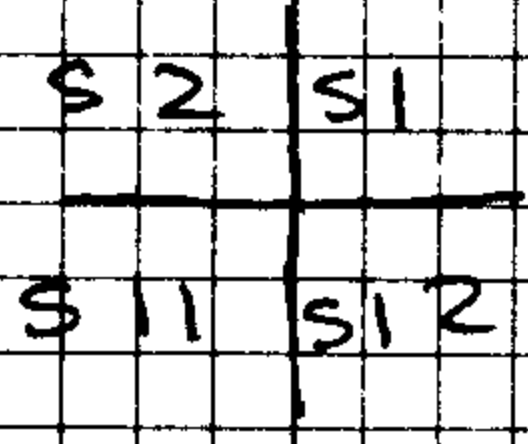

1976

NEW TREES MARKED:

A 7" WHITE FIR BEARS S45°W 41.1' DIST. MARKED 'T30S RAW S11CS BT' IN A DOUBLE BLAZE.

#263 ✓

C.S. File No. 59/89C

DIETZGEN NO. 385-6

3/11/76

T30S R4W

S2 | S1

S11 | S12

(2)

A 16" WHITE FIR BEARS N 2 1/2 W 59.6°
DISTANCE MARKED " T30S R4W S2
CS BT" IN A DOUBLE BLADE.

CORNER IS 100' OFF DAYS CREEK
ROAD UNDER A NORTH-SOUTH FENCE
BORDERING E.R. HALLS PASTURE. FENCE
BORDERS EAST SIDE OF PASTURE.

3/11/76

A. V. ~~W~~ ^{Camp}
Jim H. Cook

COMPASS DECLINATION
20° E

OK
[Signature]

DIETZGEN NO. 385-6