

3/31/76

T30S

R4W

R3W

S1

S7

CC

S12

SEE
 GEN #57 T.3-A
 # 1965 BLM RESURVEY

FOUND:

AN ORIGINAL 29" D. FIR THAT BEARS
 N29°W; 14.0'. VISIBLE SCRIBING
 ON PREVIOUSLY OPENED SE BLAZE
 THE N.E. FACE HAS BEGN CUT OUT.
 TREE IS ALIVE BUT DAMAGED.

AN ORIGINAL 20" NOW 24" D. FIR
 THAT BEARS S80°W; 11.0'. BLAZE
 IS HEALED OVER AND TREE IS
 ALIVE AND WELL.

A $\frac{3}{4}$ " X $1\frac{1}{2}$ " IRON PIPE SET AT
 THE CORNER POINT.

AT THE CORNER POINT DETERMINED
 BY ORIGINAL BEARING TREES I
 SET A 1" X 30" IRON PIPE WITH
 BRASS CAP STAMPED:

#207-T30-4 ✓
 #207-T30-3 ✓


C. S. File No. 59/8-12. C

3/31/76

DOUGLAS CO. SURVEYOR



T305

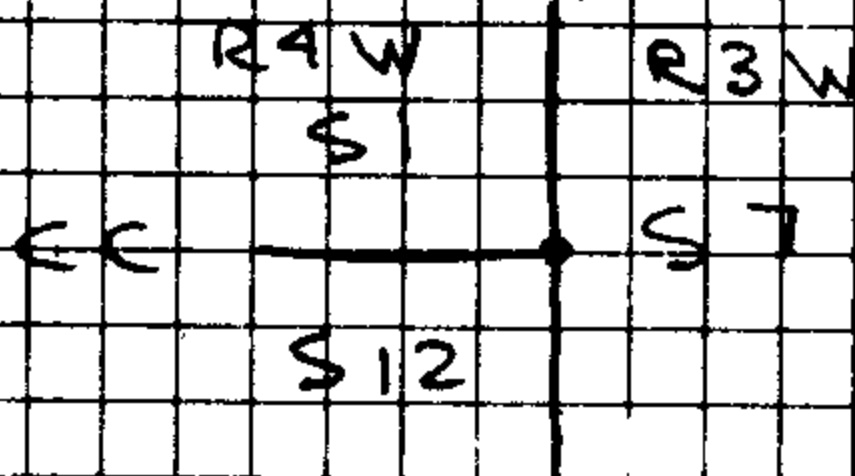

1976

I REPLACE FOUND $\frac{3}{4}$ " I.P. IN GROUND ON NORTH SIDE OF BRASS CAP.

NEW TREES:

A 10" G. FIR BEARS N71W; 79.3' DISTANCE. MARKED "T305 RAW S12 CC CS BT" IN A DOUBLE BLAZE.

COMPASS DECLINATION
20° EAST

A. Vetter ~~Comma~~
PETER L. EARLE

OK

DIETZGEN NO. 3885-6

C.S. File No. 59/8-12