


Way. Co Surveyor

PUBLIC LAND CORNERS

WEYERHAEUSER COMPANY
SPRINGFIELD BRANCH

TOWNSHIP 20S RANGE 6W
SECTION 33 CORNER SW1/16 "L"
COUNTY Douglas OREGON

#58

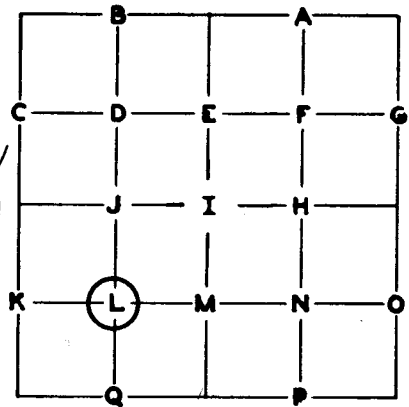

GLO SURVEY RECORD

DATE: _____
CORNER Not set by GLO

PRESENT CONDITION - (DESCRIBE FULLY - USE PAGE 2 IF NEEDED FOR EXPLANATION.)

ACCESSORIES:

	BEARING-	LINKS-	FEET-

W.N. Haines SURVEY RECORD
DATE: Oct. 1966

PRESENT CONDITION: _____

Oregon Land Surveyor No. 239
Set T iron from which:

Found T iron removed approximately 50' from previous corner position.

1 1/2" iron pipe N35°W 415.5'
18" fir S87 1/2°E 89.6' Scribed

**Found 1 1/2" iron pipe at fence angle
Found 20" Fir, low face overgrown.**

CORNER SET: Reset Haines' T iron by Haines' MAG. DECL.: 20°

Called distances and recorded new bearings as shown below.

BEARING AND DISTANCE TO ABOVE IDENTIFIED SURVEY ACCESSORIES:

BEARING-	FEET-	SURVEY -	
<u>N34 3/4°W</u>	<u>415.5</u>	<u>Haines</u>	<u>Center of 1 1/2" iron pipe.</u>
<u>S87°E</u>	<u>89.6</u>	<u>Haines</u>	<u>Center of tree measurement</u>

ACCESSORIES ADDED THIS DATE: 1/14/75

MAGNETIC DECLINATION 20°

	BEARING	FEET	ORIG. B.T.	"W" NAIL	PLATE	BRASS DISC
24" Fir	S50½° E	122.8	No	Yes	Yes	No
Power Pole "7C-158-151"	N76½° W	141.2	No	No	No	No
Distance measured to center of power pole						

IDENTIFIED ON PHOTO:

INFORMATION ON LOCATION OF CORNER AS NOW SET:

GROUND COVER: Old field recently planted to Douglas Fir

(USING FORM LINES SKETCH TOPOG AT CORNER ON PAGE 2 PLAT)

SLOPE FACES (GIVE BEARING IN DEGREES) ON MINUS (-) Level %

NORTH: Level, approx. 50' to an E-W fence, will soon be removed.

SOUTH: Level

EAST: Level approx. 180' then +10% 50' to County road; field for 20' then 2nd growth fir.

WEST: Level, open field recently planted. Approximately 620' to Smith River.

WORK DONE FOR W. CO.

FIELD NOTES IN BOOK:

BY: Glen McChesney DATE: Jan. 14, 1975

Project ENGINEER - SURVEYOR

ASSISTED BY: David Lorence, District

Engineer, Weyerhaeuser Company

Present: Daniel D. Walter, Gunter resident.

COPIES SENT TO: Office of Douglas County Surveyor, Wooley Logging Company

UNDER THE SUPERVISION OF:

REGISTERED PROFESSIONAL LAND SURVEYOR

Frank O. Williams

OREGON JULY 22, 1969 FRANK O. WILLIAMS 0875

SEAL

PAGE 3

C. S. File No. 59/11-1

36	31	32	33	34	35	36	31
1	6	5	4	3	2	1	6
12	7	8	9	10	11	12	7
13	18	17	16	15	14	13	18
24	19	20	21	22	23	24	19
25	30	29	28	27	26	25	30
36	31	32	33	34	35	36	31
1	6	5	4	3	2	1	6

REGISTERED LAND SURVEYOR
 OREGON
 REG. NO. 12345

LAND SURVEYOR
 PROFESSIONAL ENGINEER
 REG. NO. 12345

WEYERHAEUSER COMPANY

CORNER REFERENCE METHOD CONSISTS OF:

A "W" NAIL DRIVEN THRU THE HOLE IN A BRASS DISC, INTO A NOTCH CUT LOW ON A TREE, STAMPED WITH THE OREGON REGISTERED LAND SURVEYOR OR PROFESSIONAL ENGINEER REGISTRATION NUMBER.

AN EMBOSSED ALUMINUM PLATE, NAILED HEAD HIGH ON SAME TREE WITH 8D ALUMINUM NAILS, WITH DISTANCE AND BEARING FROM THE "W" NAIL TO THE CORNER STAMPED ON IT.

