



SECTION 10 TOWNSHIP 24S RANGE 2W

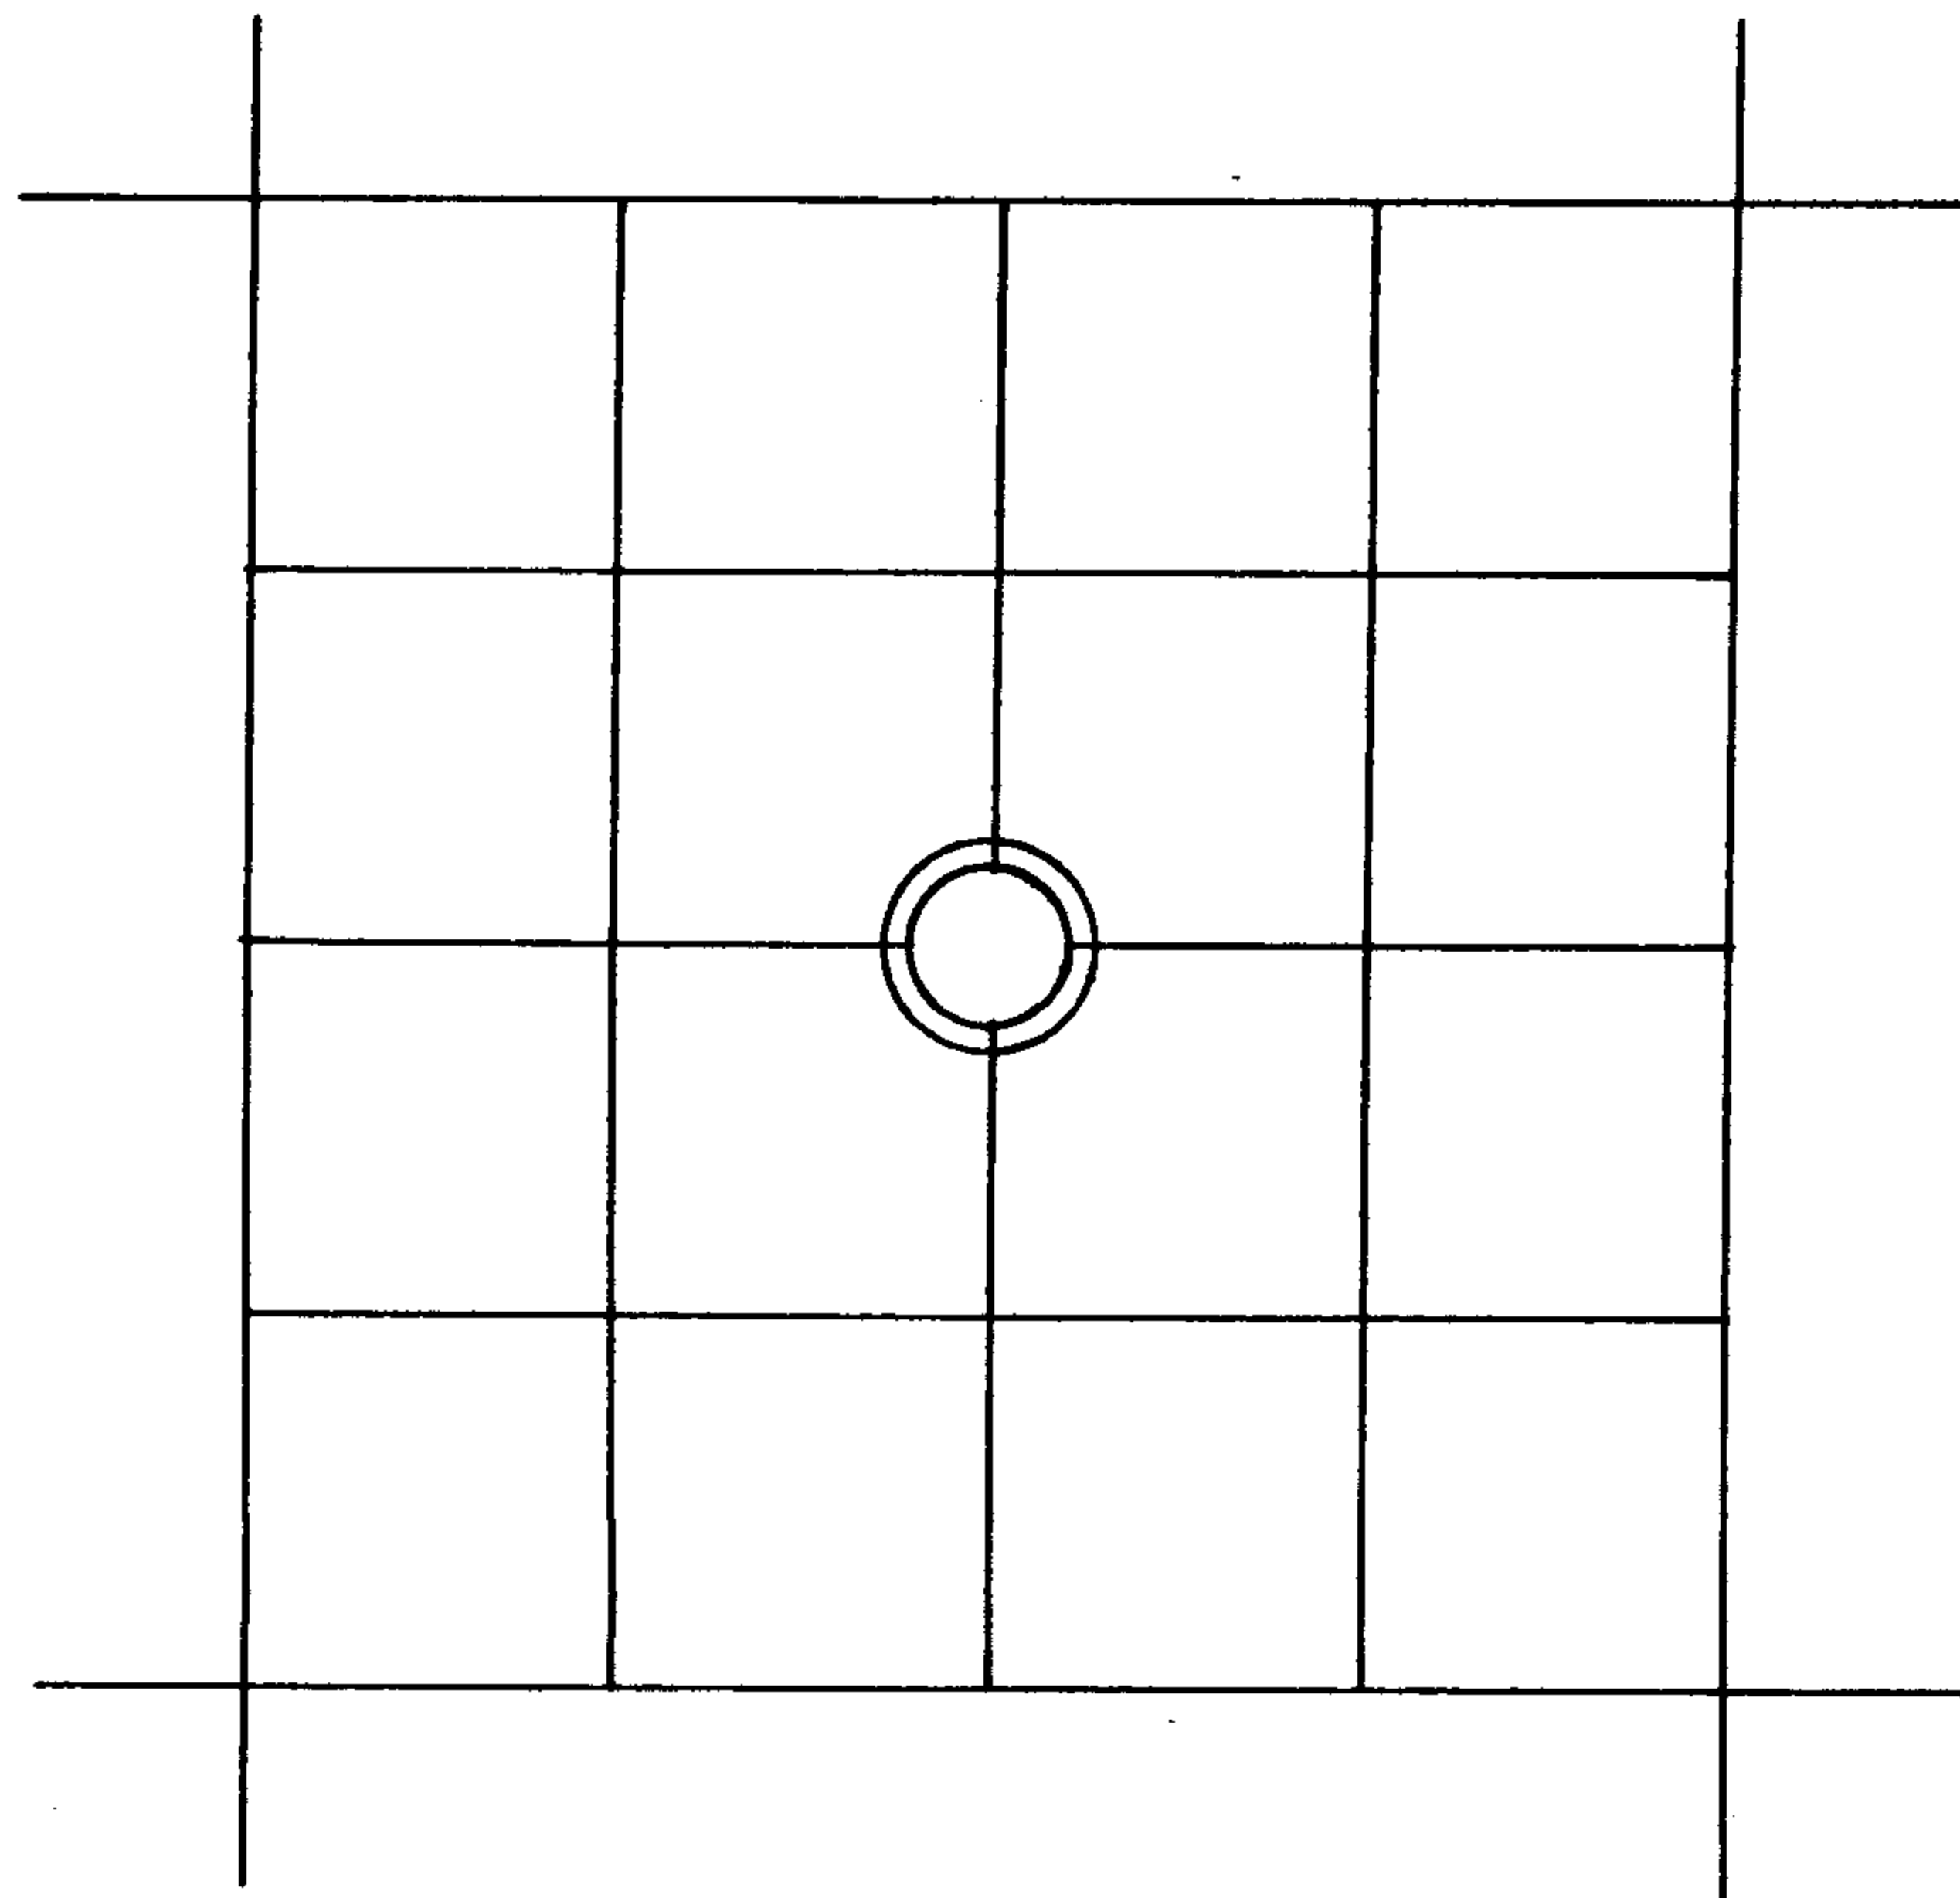

 LINE MARKED BY NOTCH CUT IN BLAZE.

 --- KNOWN CORNER.

 --- REFERENCED CORNER
BY WEYERHAEUSER
METHOD.

ACCESSORIES ADDED THIS DATE:

MAGNETIC DECLINATION 20°

	BEARING	FEET	ORIG. B.T.	'W' NAIL	PLATE	BRASS DISC
36" Fir Stump	N06E	26.0'	---	X	X	---
52" Fir	S68W	7.6'	---	X	X	---

IDENTIFIED ON PHOTO:

INFORMATION ON LOCATION OF CORNER AS NOW SET:

GROUND COVER: Logged to south, old growth unit to north soon to be logged.

(USING FORM LINES SKETCH TOPOG AT CORNER ON PAGE 2 PLAT)

SLOPE FACES (GIVE BEARING IN DEGREES) South ON MINUS (-) 50%

NORTH: +50%

SOUTH: -50%

EAST: +35%

WEST: -8%

FROM CORNER -

FILED RECEIVED
 APR 8 1976
 COUNTY SURVEYOR
 DOUGLAS COUNTY, ORE.

WORK DONE FOR W. CO.

FIELD NOTES IN BOOK: _____

BY: Glen McChesney DATE: _____

Project Engineer

ASSISTED BY: _____

UNDER THE SUPERVISION OF:

COPIES SENT TO: _____

SEAL

PAGE 3

C. S. File No. 59/11-2

36	31	32	33	34	35	36	31
1	6	5	4	3	2	1	6
12	7	8	9	10	11	12	7
13	18	17	16	15	14	13	18
24	19	20	21	22	23	24	19
25	30	29	28	27	26	25	30
36	31	32	33	34	35	36	31
1	6	5	4	3	2	1	6

WEYERHAEUSER COMPANY

CORNER REFERENCE METHOD CONSISTS OF:

A "W" NAIL DRIVEN THRU THE HOLE IN A BRASS DISC, INTO A NOTCH CUT LOW ON A TREE, STAMPED WITH THE OREGON REGISTERED LAND SURVEYOR OR PROFESSIONAL ENGINEER REGISTRATION NUMBER.

AN EMBOSSED ALUMINUM PLATE, NAILED HEAD HIGH ON SAME TREE WITH 8D ALUMINUM NAILS, WITH DISTANCE AND BEARING FROM THE "W" NAIL TO THE CORNER STAMPED ON IT.

