


# PUBLIC LAND CORNERS

WEYERHAEUSER COMPANY  
 SPRINGFIELD BRANCH

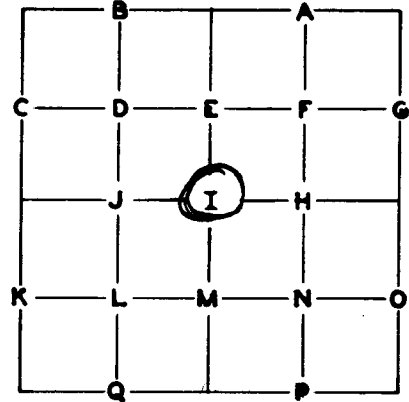

TOWNSHIP 248 RANGE 3W  
 SECTION 17 CORNER C<sub>1</sub>-I  
 COUNTY Douglas OREGON

GLO SURVEY RECORD				PRESENT CONDITION - (DESCRIBE FULLY - USE PAGE 2 IF NEEDED FOR EXPLANATION.)			
DATE: _____							
CORNER <u>Not set by GLO</u>							
ACCESSORIES:							
	BEARING-	LINKS-	FEET-	<p style="text-align: center;">FILED                  RECEIVED                  APR 5 1976                  COUNTY SURVEYOR                  DOUGLAS COUNTY, ORE.</p>			
Baughman SURVEY RECORD				PRESENT CONDITION: _____			
DATE: <u>Feb. 1973</u>							
At intersection of N-S & E-W Centerlines							
set a Brass Cap from which 2 scribed							
BT's:							
20" Cedar N74°E 16.4'				20" Incense Cedar - Scribed			
22" D. Fir N40°W 17.4'				22" Fir			

CORNER SET: Brass Cap as set by Baughman Survey MAG. DECL.: \_\_\_\_\_

BEARING AND DISTANCE TO ABOVE IDENTIFIED SURVEY ACCESSORIES:

BEARING-	FEET-	SURVEY-	



ACCESSORIES ADDED THIS DATE:

MAGNETIC DECLINATION 20°

	BEARING	FEET	ORIG. B.T.	'W' NAIL	PLATE	BRASS DISC
26" Fir	N40°W	17.0	Baughman	X	X	---
28" Incense Cedar	N73°E	16.2	"	X	X	--

IDENTIFIED ON PHOTO:

INFORMATION ON LOCATION OF CORNER AS NOW SET:

GROUND COVER: Salal and 2nd Growth

(USING FORM LINES SKETCH TOPOG AT CORNER ON PAGE 2 PLAT)

SLOPE FACES (GIVE BEARING IN DEGREES) \_\_\_\_\_ ON MINUS (-) \_\_\_\_\_ %

NORTH: + 6%

SOUTH: - 6%

EAST: - 30%

WEST: + 30%

FROM CORNER -

FILED RECEIVED

APR 8 1976

CLATSOP COUNTY SURVEYOR  
CLATSOP COUNTY, ORE.

WORK DONE FOR W. CO. \_\_\_\_\_

FIELD NOTES IN BOOK: \_\_\_\_\_

BY: Glen McChesney DATE: 4/23/73  
Project ENGINEER - ~~SURVEYOR~~

ASSISTED BY: M. Palanuk

UNDER THE SUPERVISION OF:

COPIES SENT TO: \_\_\_\_\_

SEAL

PAGE 3

C. S. File No. 59/11-4

36	31	32	33	34	35	36	31
1	6	5	4	3	2	1	6
12	7	8	9	10	11	12	7
13	18	17	16	15	14	13	18
24	19	20	21	22	23	24	19
25	30	29	28	27	26	25	30
36	31	32	33	34	35	36	31
1	6	5	4	3	2	1	6

## WEYERHAEUSER COMPANY

CORNER REFERENCE METHOD CONSISTS OF:

A "W" NAIL DRIVEN THRU THE HOLE IN A BRASS DISC, INTO A NOTCH CUT LOW ON A TREE, STAMPED WITH THE OREGON REGISTERED LAND SURVEYOR OR PROFESSIONAL ENGINEER REGISTRATION NUMBER.

AN EMBOSSED ALUMINUM PLATE, NAILED HEAD HIGH ON SAME TREE WITH 8D ALUMINUM NAILS, WITH DISTANCE AND BEARING FROM THE "W" NAIL TO THE CORNER STAMPED ON IT.

