


PUBLIC LAND CORNERS

Doug. Co.

WEYERHAEUSER COMPANY
SPRINGFIELD BRANCH

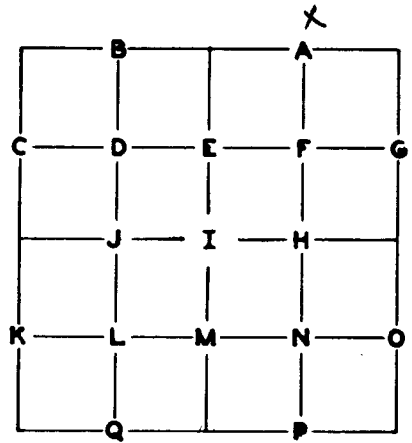

TOWNSHIP 24S RANGE 3W
 SECTION 17 CORNER E1/16 "A"
 COUNTY Douglas OREGON

GLO SURVEY RECORD

DATE: _____
 CORNER Not set by GLO

PRESENT CONDITION - (DESCRIBE FULLY - USE PAGE 2 IF NEEDED FOR EXPLANATION.)

ACCESSORIES:

	BEARING-	LINKS-	FEET-

**FILED
RECEIVED**
 APR 5 1976
 COUNTY SURVEYOR
 DOUGLAS COUNTY, ORE

Baughman SURVEY RECORD
 DATE: Feb. 1973
 Set 5/8" iron rod by single proportion.
 Scribed:
6" Hemlock N10°W26.3'
34" Hemlock S04°W43.1'

PRESENT CONDITION: _____
6" Hemlock - Scribed
34" Hemlock - Scribed

CORNER SET: 5/8" iron rod as set by Baughman MAG. DECL.: _____
Survey

BEARING AND DISTANCE TO ABOVE IDENTIFIED SURVEY ACCESSORIES:

BEARING-	FEET-	SURVEY-

ACCESSORIES ADDED THIS DATE:

MAGNETIC DECLINATION 20°

	BEARING	FEET	ORIG. B.T.	'W' NAIL	PLATE	BRASS DISC
26" Hemlock	S07°W	42.5	---	X	X	---
60" Fir	S34W	53.9	---	X	X	---

IDENTIFIED ON PHOTO:

INFORMATION ON LOCATION OF CORNER AS NOW SET:

GROUND COVER: Salal, 2nd growth fir

(USING FORM LINES SKETCH TOPOG AT CORNER ON PAGE 2 PLAT)

SLOPE FACES (GIVE BEARING IN DEGREES) S60°E ON MINUS (-) 46 %

NORTH: - 31%

SOUTH: - 30%

EAST: - 47%

WEST: - 46%

FROM CORNER -

FILED RECEIVED

APR 5 1976

COUNTY SURVEYOR DOUGLAS COUNTY, ORE.

WORK DONE FOR W. CO. _____

FIELD NOTES IN BOOK: _____

BY: Glen McChesney DATE: 4/20/73
Project ENGINEER - ~~XXXXXXXX~~

UNDER THE SUPERVISION OF:

ASSISTED BY: _____

COPIES SENT TO: _____

SEAL

36	31	32	33	34	35	36	31
1	6	5	4	3	2	1	6
12	7	8	9	10	11	12	7
13	18	17	16	15	14	13	18
24	19	20	21	22	23	24	19
25	30	29	28	27	26	25	30
36	31	32	33	34	35	36	31
1	6	5	4	3	2	1	6

WEYERHAEUSER COMPANY

CORNER REFERENCE METHOD CONSISTS OF:

A "W" NAIL DRIVEN THRU THE HOLE IN A BRASS DISC, INTO A NOTCH CUT LOW ON A TREE, STAMPED WITH THE OREGON REGISTERED LAND SURVEYOR OR PROFESSIONAL ENGINEER REGISTRATION NUMBER.

AN EMBOSSED ALUMINUM PLATE, NAILED HEAD HIGH ON SAME TREE WITH 8D ALUMINUM NAILS, WITH DISTANCE AND BEARING FROM THE "W" NAIL TO THE CORNER STAMPED ON IT.

