

PUBLIC LAND CORNERS


FILED
RECEIVED

APR 1 1976

WEYERHAEUSER COMPANY
SPRINGFIELD BRANCH

COUNTY SURVEYOR
DOUGLAS COUNTY, ORE.

TOWNSHIP 25S RANGE 2W
SECTION 12 (only) CORNER SE
COUNTY Douglas OREGON

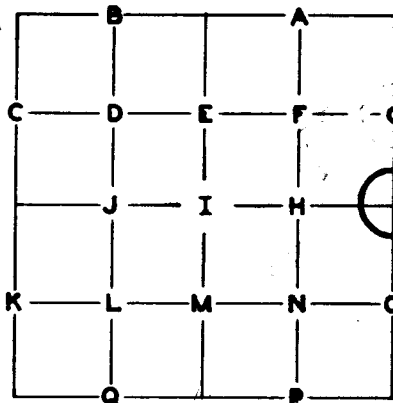

GLO SURVEY RECORD

PRESENT CONDITION - (DESCRIBE FULLY - USE PAGE 2 IF NEEDED FOR EXPLANATION.)

DATE: 1951
CORNER Set brass cap with original stone buried alongside

Found brass cap. No trace of original stone.

ACCESSORIES:

	BEARING-	LINKS-	FEET-
6" Incense Cedar	N20W	49	32.3
10" Fir	S07W	20	13.2

12" Incense Cedar, face healed over, Douglas County BT plate.
10" Fir, scribing visible on low face. Douglas County BT plate.

V. W. Hosford SURVEY RECORD

DATE: 1950
Steel Cap
12" Fir S23W 9.1'
18" Fir N35W 21.0'
This Hosford brass cap bears South 8.2 feet from GLO brass cap.

PRESENT CONDITION: _____
Found.
16" Fir S23W 9.1 scribing visible.
24" Fir N34W 22.0' face healed over.
Center of tree measurement.

CORNER SET: ~~XXX~~ GLO brass cap as found MAG. DECL.: 20° E

BEARING AND DISTANCE TO ABOVE IDENTIFIED SURVEY ACCESSORIES:

BEARING-	FEET-	SURVEY -	
<u>N19W</u>	<u>32.7</u>	<u>1951</u>	<u>Center of tree measurement.</u>
<u>S08W</u>	<u>13.5</u>	<u>1951</u>	<u>Center of tree measurement.</u>

ACCESSORIES ADDED THIS DATE:

MAGNETIC DECLINATION 20°

	BEARING	FEET	ORIG. B.T.	'W' NAIL	PLATE	BRASS DISC
36" Fir	S36W	35.4	---	X	X	---
24" Fir	N52W	14.2	---	X	X	---
These references are to the GLO Brass Cap.						

IDENTIFIED ON PHOTO:

INFORMATION ON LOCATION OF CORNER AS NOW SET:

GROUND COVER: Salal, vine maple

(USING FORM LINES SKETCH TOPOG AT CORNER ON PAGE 2 PLAT)

SLOPE FACES (GIVE BEARING IN DEGREES) South ON MINUS (-) 15 %

NORTH: + 15%

SOUTH: - 15% 8.2' to Hosford's Brass Cap

EAST: - 5%

WEST: Level

FROM CORNER -

FILED
RECEIVED

APR 8 1976

COUNTY SURVEYOR
LUGEL'S COUNTY, ORE.

WORK DONE FOR W. CO. _____

FIELD NOTES IN BOOK: _____

BY: Glen McChesney DATE: 2/24/1975
Project ENGINEER - ~~SURVEYOR~~

UNDER THE SUPERVISION OF:

ASSISTED BY: _____

REGISTERED
PROFESSIONAL
LAND SURVEYOR

Frank D. Williams

OREGON
JULY 22, 1966
FRANK D. WILLIAMS
0922

COPIES SENT TO: _____

SEAL

PAGE 3

G. S. File No. 59/11-6

36	31	32	33	34	35	36	31
1	6	5	4	3	2	1	6
12	7	8	9	10	11	12	7
13	18	17	16	15	14	13	18
24	19	20	21	22	23	24	19
25	30	29	28	27	26	25	30
36	31	32	33	34	35	36	31
1	6	5	4	3	2	1	6

STATE OF OREGON
 DEPARTMENT OF LANDS
 OFFICE OF THE SURVEYOR
 OREGON

2004

WEYERHAEUSER COMPANY

CORNER REFERENCE METHOD CONSISTS OF:

A "W" NAIL DRIVEN THRU THE HOLE IN A BRASS DISC, INTO A NOTCH CUT LOW ON A TREE, STAMPED WITH THE OREGON REGISTERED LAND SURVEYOR OR PROFESSIONAL ENGINEER REGISTRATION NUMBER.

AN EMBOSSED ALUMINUM PLATE, NAILED HEAD HIGH ON SAME TREE WITH 8D ALUMINUM NAILS, WITH DISTANCE AND BEARING FROM THE "W" NAIL TO THE CORNER STAMPED ON IT.

