


# PUBLIC LAND CORNERS

WEYERHAEUSER COMPANY  
 SPRINGFIELD BRANCH

TOWNSHIP 25S RANGE 2W  
 SECTION 14 CORNER W $\frac{1}{2}$   
 COUNTY Douglas OREGON

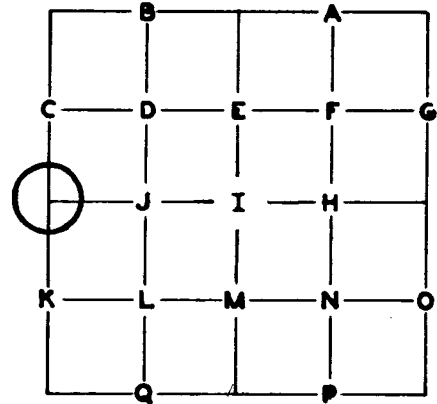

**GLO SURVEY RECORD**

DATE: 1900  
 CORNER Pine Post

PRESENT CONDITION - (DESCRIBE FULLY -  
 USE PAGE 2 IF NEEDED FOR EXPLANATION.)

No trace

**ACCESSORIES:**

	BEARING-	LINKS-	FEET-
15" <i>Fir</i>	N42W	25	16.5
6" Chinquapin	S57E	26	17.2

26" *Fir* scribing visible.  
 10" Chinquapin, faces rotted.

FILED  
 RECEIVED  
 APR 5 1976  
 COUNTY SURVEYOR  
 DOUGLAS COUNTY, ORE.

**Douglas County SURVEY RECORD**

F. M. Darby DATE: 7/14/58  
 Found 10" Chinquapin S57E 17.2' & 26"  
 Fir N42W 16.5', scribing visible.  
 Set 1" iron pipe & brass cap & scribed:  
 5" Hemlock S45E 11.5'  
 Found iron pipe proportioned by B. Irving  
 1948 County Survey S59W 111.5'.

PRESENT CONDITION:


Found brass cap.  
 8" Hemlock, scribing visible.  
 Found 1" iron pipe and 2 BTs

CORNER ~~set~~: Brass cap as found MAG. DECL.: 20°

**BEARING AND DISTANCE TO ABOVE IDENTIFIED SURVEY ACCESSORIES:**

BEARING-	FEET-	SURVEY -	
N40W	17.3	1900	Center of tree measurement
S56E	17.3	1900	Center of tree measurement
S46E	11.3	7/14/58	Center of tree measurement

SECTION 14 TOWNSHIP 25S RANGE 2W

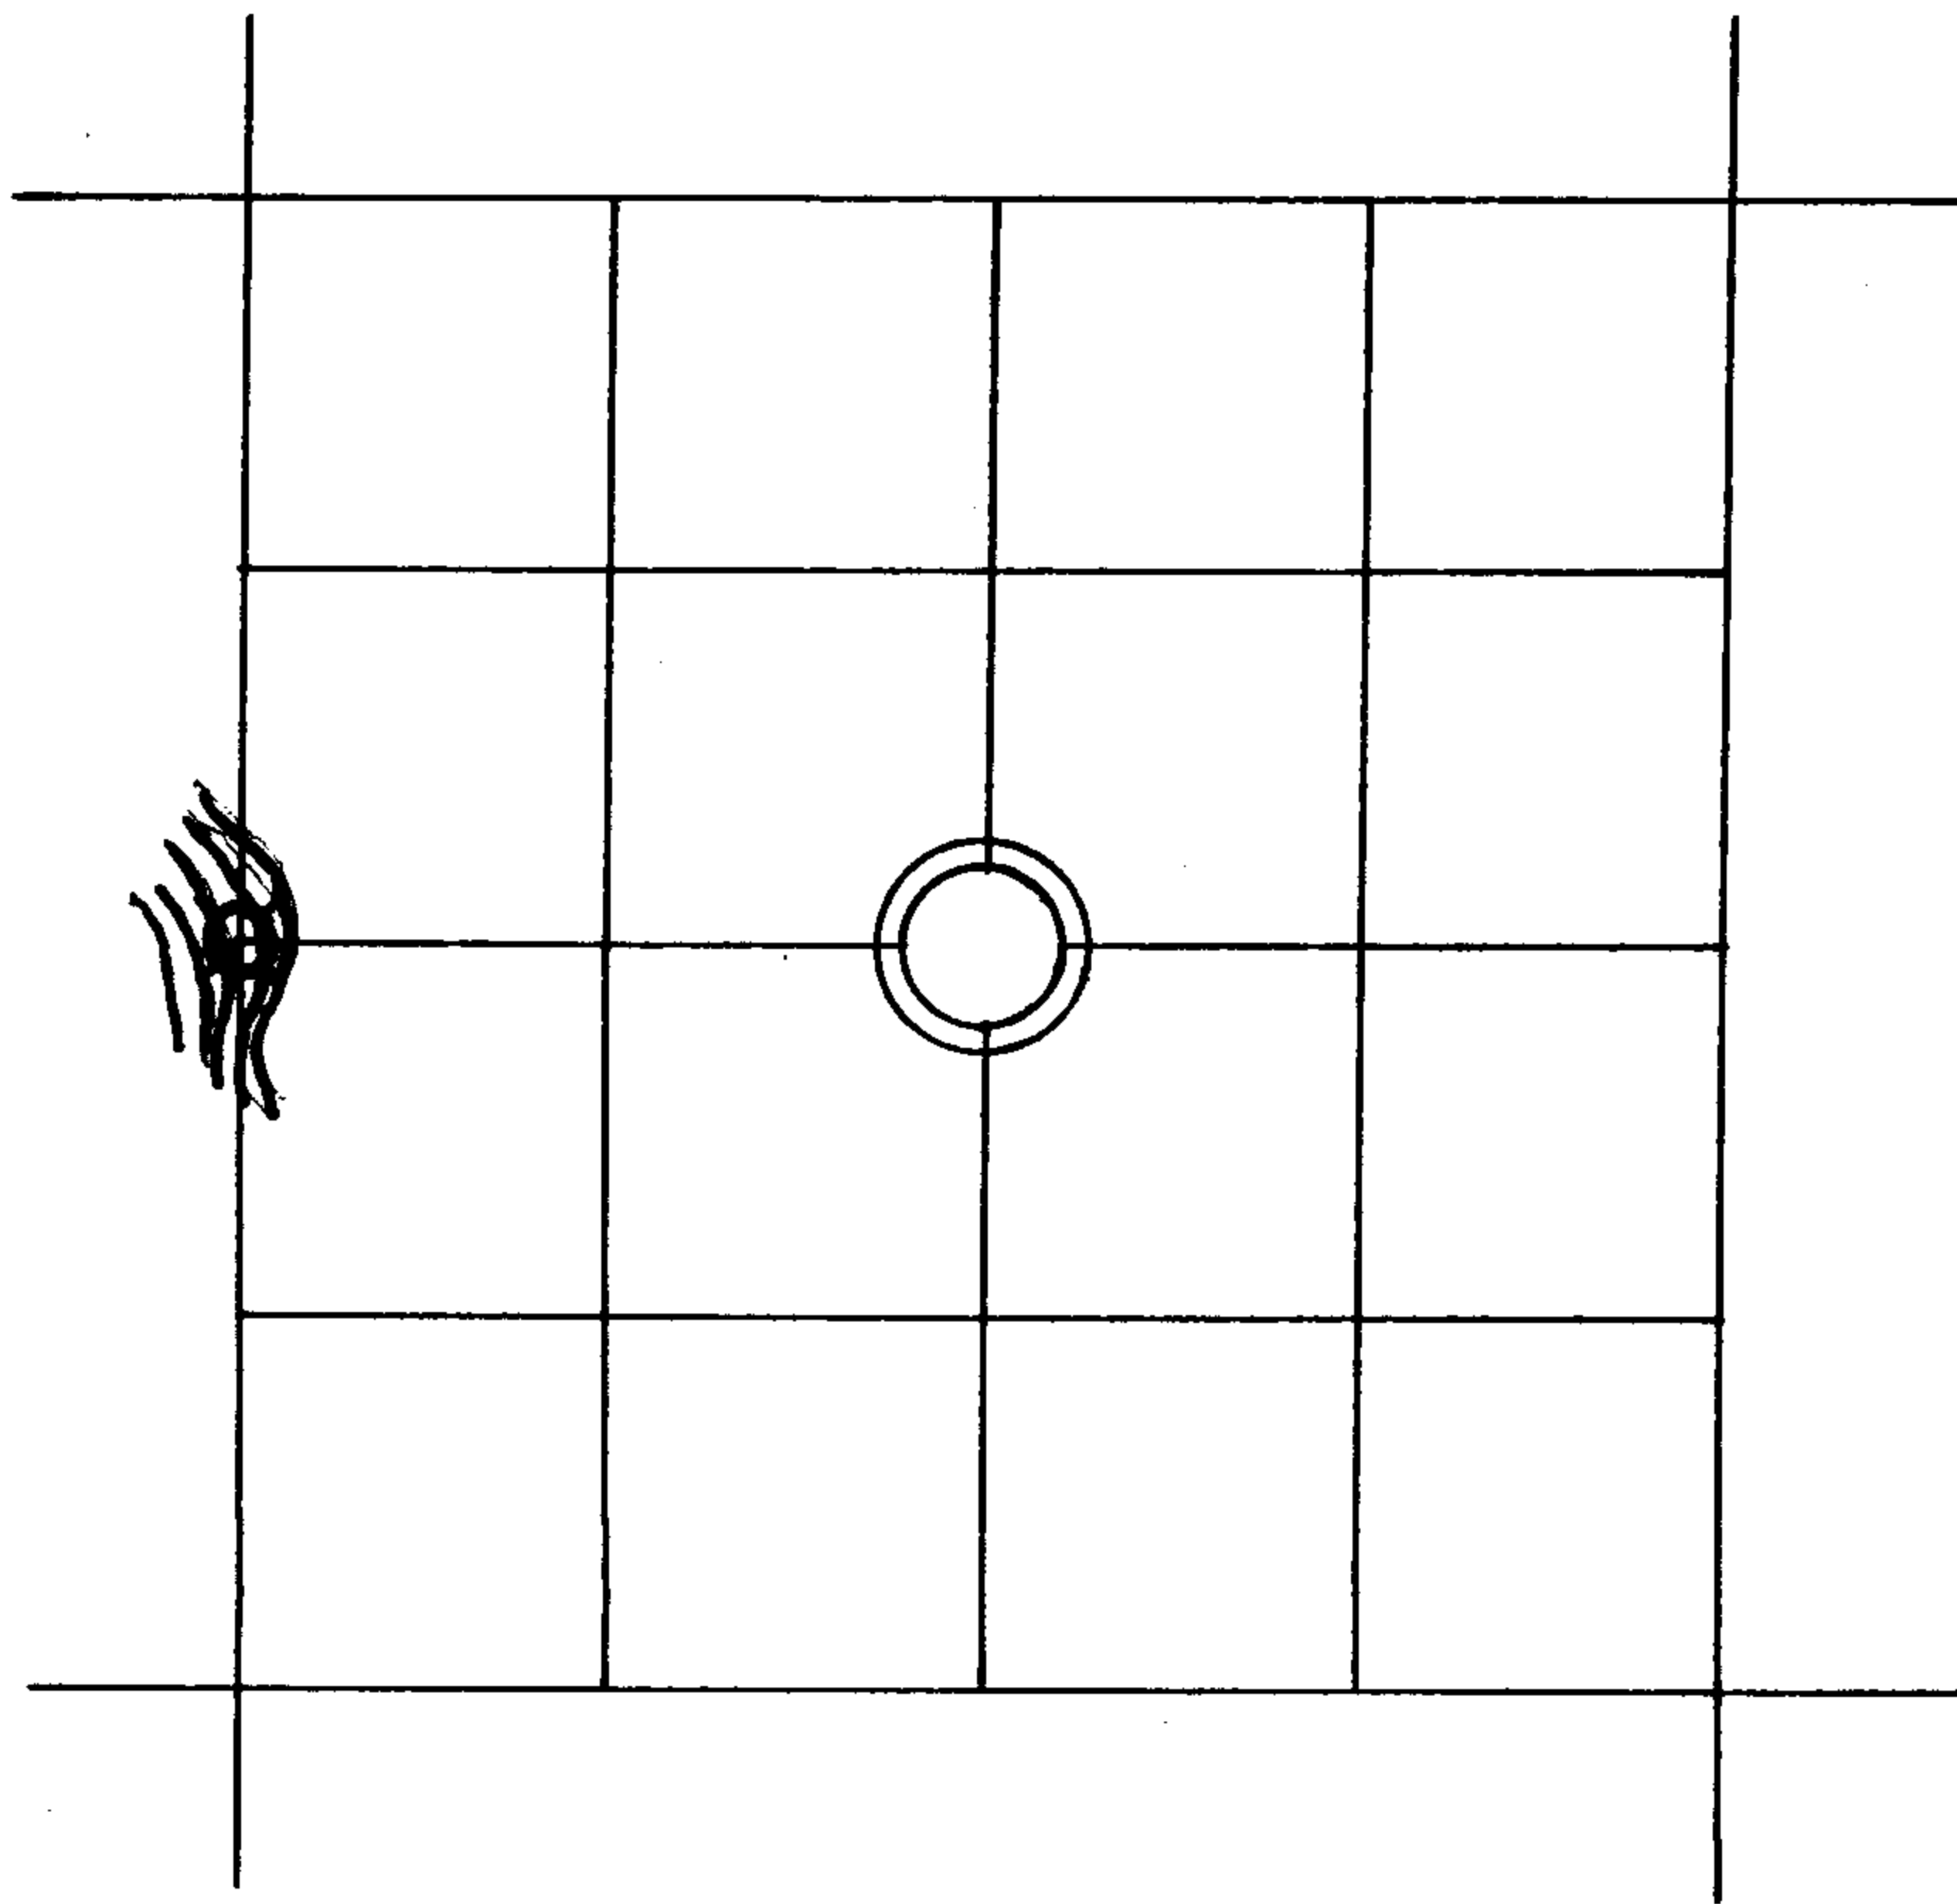

—||—||—||— LINE MARKED BY NOTCH CUT IN BLAZE.

○ — KNOWN CORNER.

⊙ — REFERENCED CORNER BY WEYERHAEUSER METHOD.

1" Iron Pipe  
 Encorrectly set as the W<sup>1</sup>/<sub>4</sub> cor Sec 14  
 by Douglas Co. Survey Feb. 1940

93.10'  
 NB7-54-25E

15' — Douglas Co. Surveyors Brass Cap at original <sup>1</sup>/<sub>4</sub> Cor  
 Baughman Surveying Service, Inc.  
 Per their Survey of West Line Sec 14  
 for Weyerhaeuser Co. Aug. 1975

59.65'  
 50-25-17E

ACCESSORIES ADDED THIS DATE:

MAGNETIC DECLINATION 20°

	BEARING	FEET	ORIG. B.T.	'W' NAIL	PLATE	BRASS DISC
44" Sugar Pine	N68E	18.7	---	X	X	---
38" Incense Cedar	S35E	20.7	---	X	X	---

IDENTIFIED ON PHOTO:

INFORMATION ON LOCATION OF CORNER AS NOW SET:

GROUND COVER: \_\_\_\_\_

(USING FORM LINES SKETCH TOPOG AT CORNER ON PAGE 2 PLAT)

SLOPE FACES (GIVE BEARING IN DEGREES) East ON MINUS (-) 35 %

NORTH: -20%

SOUTH: -10%

EAST: -35%

WEST: +30%

FROM CORNER -

FILED RECEIVED

APR 6 1976  
COUNTY SURVEYOR  
LOUGLAS COUNTY, ORE.

WORK DONE FOR W. CO. \_\_\_\_\_

FIELD NOTES IN BOOK: \_\_\_\_\_

BY: Glen McChenney DATE: 10/30/75  
Project ENGINEER - SURVEYOR

ASSISTED BY: \_\_\_\_\_

COPIES SENT TO: \_\_\_\_\_

UNDER THE SUPERVISION OF:

REGISTERED PROFESSIONAL LAND SURVEYOR

*Frank O. Williams*

OREGON  
JULY 22, 1969  
FRANK O. WILLIAMS  
0878

SEAL

PAGE 3

C. S. File No. 59/11-7

36	31	32	33	34	35	36	31
1	6	5	4	3	2	1	6
12	7	8	9	10	11	12	7
13	18	17	16	15	14	13	18
24	19	20	21	22	23	24	19
25	30	29	28	27	26	25	30
36	31	32	33	34	35	36	31
1	6	5	4	3	2	1	6

ORIG  
 MARK OF MISTAKE  
 MAY 15 1898  
 OREGON

FUND SURVEYOR  
 PROFESSIONAL  
 REGISTERED

## WEYERHAEUSER COMPANY

CORNER REFERENCE METHOD CONSISTS OF:

A "W" NAIL DRIVEN THRU THE HOLE IN A BRASS DISC, INTO A NOTCH CUT LOW ON A TREE, STAMPED WITH THE OREGON REGISTERED LAND SURVEYOR OR PROFESSIONAL ENGINEER REGISTRATION NUMBER.

AN EMBOSSED ALUMINUM PLATE, NAILED HEAD HIGH ON SAME TREE WITH 8D ALUMINUM NAILS, WITH DISTANCE AND BEARING FROM THE "W" NAIL TO THE CORNER STAMPED ON IT.

