


PUBLIC LAND CORNERS

WEYERHAEUSER COMPANY
 SPRINGFIELD BRANCH

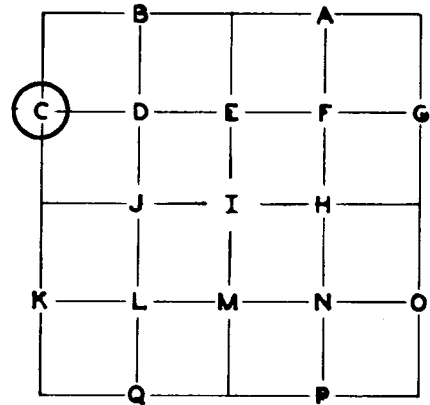

TOWNSHIP 26S RANGE 2W
 SECTION 8 CORNER N-1/16C
 COUNTY Douglas OREGON

GLO SURVEY RECORD

PRESENT CONDITION - (DESCRIBE FULLY -
 USE PAGE 2 IF NEEDED FOR EXPLANATION.)

DATE: _____
 CORNER _____

ACCESSORIES:

BEARING-	LINKS-	FEET-

FILED
RECEIVED
 COUNTY SURVEYOR
 DOUGLAS COUNTY, ORE

Baughman SURVEY RECORD
 DATE: May 1975
 Transit Survey for Weyerhaeuser Co.
 Set 5/8" Iron rod
 6" D. Fir N38E 12.2'
 8" D. Fir S10W 17.0'

PRESENT CONDITION: 7/18/1975

Found
 6" Fir, Scribed low face.
 8" Fir, Scribed low face.

CORNER ~~SET~~: 5 8" Iron Rod as found MAG. DECL.: 20°

BEARING AND DISTANCE TO ABOVE IDENTIFIED SURVEY ACCESSORIES:

BEARING-	FEET-	SURVEY -	
N35E	12.2	Baughman	Center of tree measurement.
S09W	17.0	Baughman	Center of tree measurement.

ACCESSORIES ADDED THIS DATE: 7/18/75

MAGNETIC DECLINATION 20°

	BEARING	FEET	ORIG. B.T.	"W" NAIL	PLATE	BRASS DISC
16" Fir	S51W	9.2	---	X	X	---
12" Fir	N33W	10.2	---	X	X	---
6" Fir	N35E	12.2	Baughman	---	X	---
8" Fir	S09W	17.0	Baughman	---	X	---

IDENTIFIED ON PHOTO:

INFORMATION ON LOCATION OF CORNER AS NOW SET:

GROUND COVER: Chinquapin, Salal

(USING FORM LINES SKETCH TOPOG AT CORNER ON PAGE 2 PLAT)

SLOPE FACES (GIVE BEARING IN DEGREES) East ON MINUS (-) 60 %

NORTH: + 15% approx.

SOUTH: - 15% approx.

EAST: - 60% approx.

WEST: + 40% approx.

FROM CORNER -

FILED RECEIVED

COUNTY SURVEYOR
CLATSOP COUNTY, ORE.

WORK DONE FOR W. CO.

FIELD NOTES IN BOOK:

BY: Glen McChesney DATE: 7/18/1975
Project ENGINEER - SURVEYOR

UNDER THE SUPERVISION OF:

ASSISTED BY:

REGISTERED PROFESSIONAL LAND SURVEYOR

Frank O. Williams

OREGON
JULY 12, 1968
FRANK O. WILLIAMS
0675

COPIES SENT TO:

SEAL

PAGE 3

C. S. File No. 59/11-11

36	31	32	33	34	35	36	31
1	6	5	4	3	2	1	6
12	7	8	9	10	11	12	7
13	18	17	16	15	14	13	18
24	19	20	21	22	23	24	19
25	30	29	28	27	26	25	30
36	31	32	33	34	35	36	31
1	6	5	4	3	2	1	6

STATE OF OREGON
 BOARD OF LAND SURVEYORS
 OREGON

LAND SURVEYOR
 PROFESSIONAL
 REGISTERED

WEYERHAEUSER COMPANY

CORNER REFERENCE METHOD CONSISTS OF:

A "W" NAIL DRIVEN THRU THE HOLE IN A BRASS DISC, INTO A NOTCH CUT LOW ON A TREE, STAMPED WITH THE OREGON REGISTERED LAND SURVEYOR OR PROFESSIONAL ENGINEER REGISTRATION NUMBER.

AN EMBOSSED ALUMINUM PLATE, NAILED HEAD HIGH ON SAME TREE WITH 8D ALUMINUM NAILS, WITH DISTANCE AND BEARING FROM THE "W" NAIL TO THE CORNER STAMPED ON IT.

