


PUBLIC LAND CORNERS

WEYERHAEUSER COMPANY
 SPRINGFIELD BRANCH

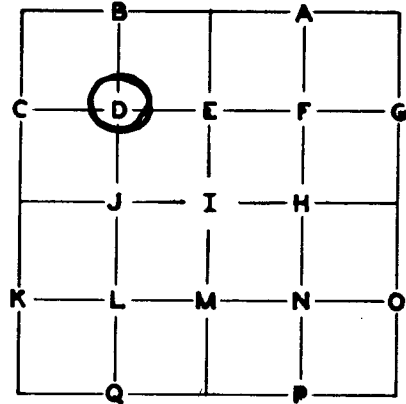

TOWNSHIP 26S RANGE 2W
 SECTION 8 CORNER NW-1/16D
 COUNTY Douglas OREGON

GLO SURVEY RECORD

PRESENT CONDITION - (DESCRIBE FULLY -
 USE PAGE 2 IF NEEDED FOR EXPLANATION.)

DATE: _____
 CORNER _____

ACCESSORIES:

	BEARING-	LINKS-	FEET-

**FILED
 RECEIVED**
 APR 8 1976
 COUNTY SURVEYOR
 DOUGLAS COUNTY, ORE

Baughman SURVEY RECORD
 DATE: May 1975
 Transit survey for Weyerhaeuser Co.
 Set 5/8" Iron rod
 7" Cedar N71E 9.0'
 18" Madrone S41E 37.9'

PRESENT CONDITION: _____

Found
 7" Cedar, scribed face.
 18" Madrone, scribed face.

CORNER ~~MARK~~ 5/8" iron rod as found MAG. DECL.: 20°

BEARING AND DISTANCE TO ABOVE IDENTIFIED SURVEY ACCESSORIES:

BEARING-	FEET-	SURVEY -	
N71E	9.0	Baughman	Center of tree measurement.
S46E	37.9	Baughman	Center of tree measurement ground level.

ACCESSORIES ADDED THIS DATE:

MAGNETIC DECLINATION 20°

	BEARING	FEET	ORIG. B.T.	"W" NAIL	PLATE	BRASS DISC
40" Fir	N40E	34.5	---	X	X	---
28" Fir	S82W	21.5	---	X	X	---
7" Cedar	N71E	9.0	Baughman	---	X	---
18" Madrone	S46E	37.9	"	---	X	---

IDENTIFIED ON PHOTO:

INFORMATION ON LOCATION OF CORNER AS NOW SET:

GROUND COVER: Salal, Huckleberry

(USING FORM LINES SKETCH TOPOG AT CORNER ON PAGE 2 PLAT)

SLOPE FACES (GIVE BEARING IN DEGREES) East ON MINUS (-) 45 %

FROM CORNER -

NORTH: + 15%

SOUTH: - 15%

EAST: - 45%

WEST: + 45%

FILED RECEIVED

APR 6 1976

COUNTY SURVEYOR DOUGLAS COUNTY, ORE.

WORK DONE FOR W. CO. _____

FIELD NOTES IN BOOK: _____

BY: Glen McChesney DATE: 7/14/1975
Project ENGINEER - ~~SURVEYOR~~

ASSISTED BY: _____

COPIES SENT TO: _____

UNDER THE SUPERVISION OF:

REGISTERED PROFESSIONAL LAND SURVEYOR

Frank O. Williams

OREGON JULY 12, 1969 FRANK O. WILLIAMS 0875

SEAL

PAGE 3

C. S. File No. 59/11-12

36	31	32	33	34	35	36	31
1	6	5	4	3	2	1	6
12	7	8	9	10	11	12	7
13	18	17	16	15	14	13	18
24	19	20	21	22	23	24	19
25	30	29	28	27	26	25	30
36	31	32	33	34	35	36	31
1	6	5	4	3	2	1	6

REGISTERED
ENGINEER
OREGON

LAND SURVEYOR
REGISTERED

WEYERHAEUSER COMPANY

CORNER REFERENCE METHOD CONSISTS OF:

A "W" NAIL DRIVEN THRU THE HOLE IN A BRASS DISC, INTO A NOTCH CUT LOW ON A TREE, STAMPED WITH THE OREGON REGISTERED LAND SURVEYOR OR PROFESSIONAL ENGINEER REGISTRATION NUMBER.

AN EMBOSSED ALUMINUM PLATE, NAILED HEAD HIGH ON SAME TREE WITH 8D ALUMINUM NAILS, WITH DISTANCE AND BEARING FROM THE "W" NAIL TO THE CORNER STAMPED ON IT.

