


PUBLIC LAND CORNERS

WEYERHAEUSER COMPANY
 SPRINGFIELD BRANCH

TOWNSHIP 26S RANGE 2W
 SECTION 18 CORNER E₄
 COUNTY Douglas OREGON

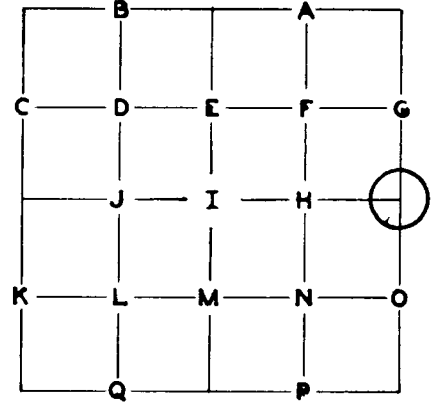

GLO SURVEY RECORD				PRESENT CONDITION - (DESCRIBE FULLY - USE PAGE 2 IF NEEDED FOR EXPLANATION.)	
DATE: <u>1959</u>					
CORNER <u>Brass cap set by single proportion.</u>				<u>Found 1959 GLO Brass Cap.</u>	
ACCESSORIES:					
	BEARING-	LINKS-	FEET-		
<u>20" Hemlock</u>	<u>N69$\frac{1}{2}$E</u>	<u>18-3/4</u>	<u>12.4</u>	<u>20" Hemlock, face healed over - BLM tag.</u>	
<u>7" Fir</u>	<u>N49$\frac{1}{2}$W</u>	<u>38</u>	<u>25.1</u>	<u>8" Fir leans to West, face healed over - BLM tag.</u>	

SURVEY RECORD				PRESENT CONDITION:	
DATE:					
				FILED RECEIVED COUNTY SURVEYOR DOUGLAS COUNTY, ORE	

CORNER ~~SET~~: Brass cap as found MAG. DECL.: 20°

BEARING AND DISTANCE TO ABOVE IDENTIFIED SURVEY ACCESSORIES:

BEARING-	FEET-	SURVEY -	
<u>N69E</u>	<u>11.6</u>	<u>1959</u>	<u>Center of tree measurement.</u>
<u>N49W</u>	<u>25.1</u>	<u>1959</u>	<u>Center of tree measurement.</u>

ACCESSORIES ADDED THIS DATE:

MAGNETIC DECLINATION 29°

	BEARING	FEET	ORIG. B.T.	'W' NAIL	PLATE	BRASS DISC
16" Hemlock	S07W	10.2	---	X	X	---
20" Sugar Pine	S62W	15.0	---	X	X	---

IDENTIFIED ON PHOTO:

INFORMATION ON LOCATION OF CORNER AS NOW SET:

GROUND COVER: Huckleberry - ground unstable

(USING FORM LINES SKETCH TOPOG AT CORNER ON PAGE 2 PLAT)

SLOPE FACES (GIVE BEARING IN DEGREES) N20W ON MINUS (-) 40 %

NORTH: -35%

SOUTH: +60%

EAST: +45%

WEST: -10%

FROM CORNER -

FILED RECEIVED
COUNTY SURVEYOR
DALLAS COUNTY, ORE.

WORK DONE FOR W. CO.

FIELD NOTES IN BOOK:

BY: Glen McChesney DATE: 3/11/75

Project ENGINEER - ~~SURVEYOR~~

ASSISTED BY:

UNDER THE SUPERVISION OF:

REGISTERED PROFESSIONAL LAND SURVEYOR

Frank O. Williams

OREGON
JULY 22, 1968
FRANK O. WILLIAMS
0675

COPIES SENT TO:

36	31	32	33	34	35	36	31
1	6	5	4	3	2	1	6
12	7	6	9	10	11	12	7
13	18	17	16	15	14	13	18
24	19	20	21	22	23	24	19
25	30	29	28	27	26	25	30
36	31	32	33	34	35	36	31
1	6	5	4	3	2	1	6

CHAS. J. WYER
 LAND SURVEYOR
 OREGON

LAND SURVEYOR
 PROFESSIONAL
 REGISTERED

WEYERHAEUSER COMPANY

CORNER REFERENCE METHOD CONSISTS OF:

A "W" NAIL DRIVEN THRU THE HOLE IN A BRASS DISC, INTO A NOTCH CUT LOW ON A TREE, STAMPED WITH THE OREGON REGISTERED LAND SURVEYOR OR PROFESSIONAL ENGINEER REGISTRATION NUMBER.

AN EMBOSSED ALUMINUM PLATE, NAILED HEAD HIGH ON SAME TREE WITH 8D ALUMINUM NAILS, WITH DISTANCE AND BEARING FROM THE "W" NAIL TO THE CORNER STAMPED ON IT.

