

5-4-76

RENEWAL

T 22 S R 12 W

$\frac{1}{4}$ $\frac{S 21}{S 28}$

(SEE RENEWAL NO. ~~30~~ ²⁹)

FOUND

²⁴
18 NOW 21 INCH

1. DIAMETER ALDER. SCRIBE ILLEGIBLE.
BEARS S 79° W, 49 $\frac{1}{2}$ FEET.

2. 18 NOW 16 INCH ALDER SNAG 13
FEET HIGH. NO SCRIBE VISIBLE
TAGGED "MOORE LO. CO. S 21 TWP
22 R 12 S $\frac{1}{4}$ COR."

DID NOT FIND 1 INCH DIAMETER
I. PIPE.

RENEWAL

1. SET BRASS CAP, 3 INCHES IN DIAMETER
AT $\frac{1}{4}$ CORNER STAMPED "T 22 S R 12 W
 $\frac{1}{4}$ $\frac{S 21}{S 28}$ 1976". CAP IS A DOUGLAS

COUNTY SURVEYORS OFFICE MONUMENT.
POSITION OF CAP DETERMINED BY
COUNTY SURV. PROJECT NO. 6004-16
BRASS CAP SET IN DRILL HOLE IN ROCK.

DIETZEN NO. 3895-6

#101

101

RENEWAL

SEE ATTACHED PAGES FOR COMPUTATIONS.

2, AN ALDER 15" DIAMETER BEARS
S 48° 08' E; 32⁰ FEET. TREE
DOUBLE BLAZED AND SCRIBED
"1/4 S 28 CS BT"

3, AN ALDER 16" DIAMETER BEARS
N 26° 40' E; 24⁰ FEET. TREE
DOUBLE BLAZED AND SCRIBED
"1/4 S 21 ES BT"

4, SET STEEL FENCE POST AND WITNESS
SIGN S 60° W, 2⁵ FEET FROM
1/4 CORNER.

NOTE: CORNER FALLS ON A STEEP
ROCK FACE SLOPING N.E.

L. E. MOURBAN

P. L. EARLE

M. L. LADIG

K. CHENEY

DIETZEN NO. 385-6

16' ALDER

F

N 67° 11' E

H

325° 29' RT
412° 10'
(350)

Z

S 2° 40' E

H

739,771.87 N
+34.56

1,028,467.54 E
+57.00

BT.

739,806.43 N

1,038,514.94 E

1/4 COR.

739,776.70 N
+29.73

1,038,498.36 E
+16.58

N 28° 09' E




N 26° 40' E

N 4° E

DIETZEN NO. 385-6

59/15-1

H.P. 35 USED FOR CALCULATING BEAR & DIST.

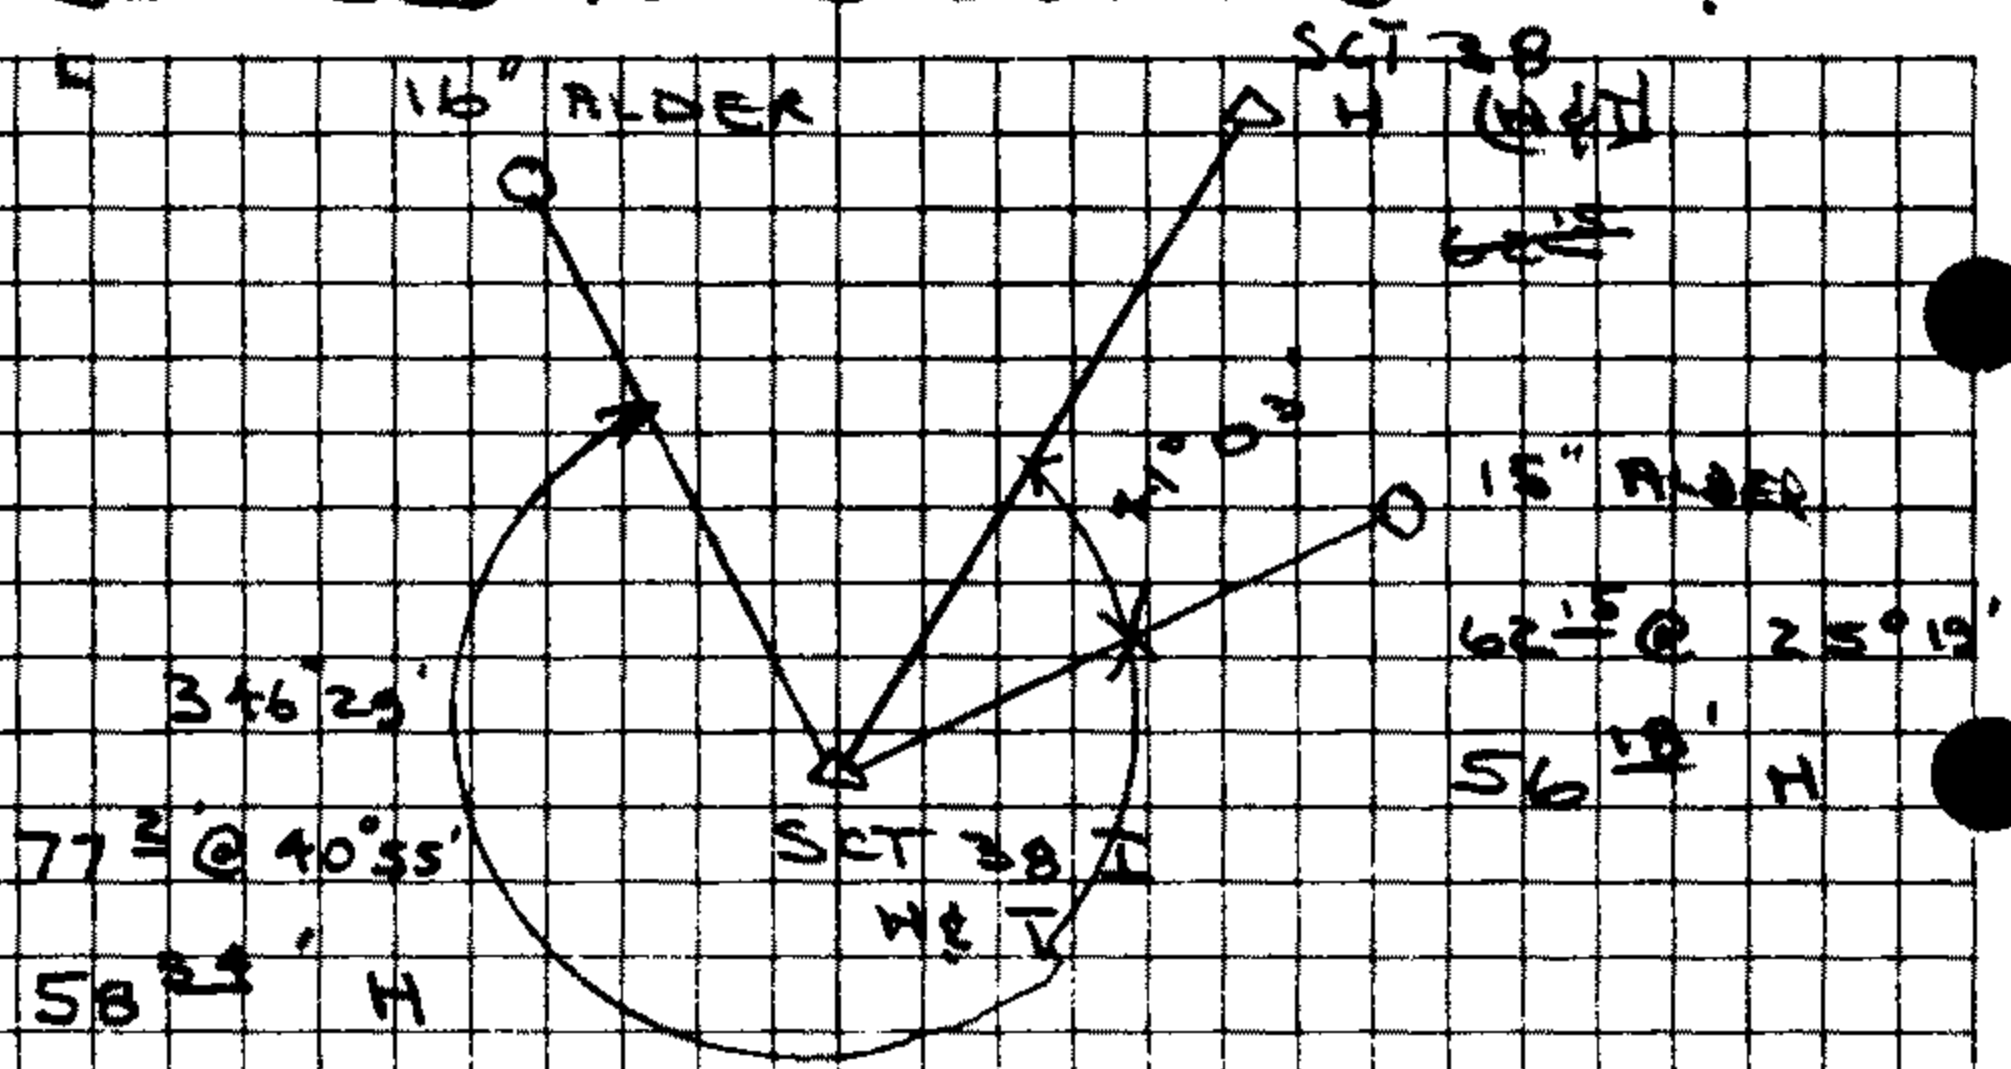

15" ALDER

N 67° 11' 00" E
 (79 00)
 108° 14'
 S 71° 46' E

I.	739,771.87 N	1,038,467.94 E
	- 17.58	+ 53.36
B.T.	739,754.29 N	1,038,521.30 E
1/4 COR	739,776.70 N	1,038,498.36 E
	- 22.41	+ 22.94

S 45° 40' E
 N 29
 S 48° 00' E 322 FT