

SEE RENEWAL # 11

FOUNDA $1\frac{1}{2}$ INCH DIAMETER

1. IRON PIPE WITH
STEEL CAP.

A FIR, 32 NOW A 38 INCH DIAMETER

2. STUMP BEARS S $78\frac{1}{2}^{\circ}$ W $37^{\frac{1}{2}}$
FEET TO CENTER ϵ ; $35^{\frac{1}{2}}$ FEET TO
FACE (REC. $35^{\frac{1}{2}}$ FEET). STUMP
IS SCRIBED "T 255 R 2 W S 25
P S 253 BT".

A FIR, 30 NOW 33 INCH DIAMETER

3. BEARS N 39° W, $17^{\frac{1}{2}}$ FEET TO
CENTER ϵ ; $16^{\frac{1}{2}}$ FEET TO FACE (REC.
 $16^{\frac{1}{2}}$ FEET).


RENEWAL

1. I REMOVED IRON PIPE AND STEEL
CAP AND REPLACE IT WITH A
BRASS CAP, AT $\frac{1}{4}$ CORNER,
STAMPED;

#127 T 25-1 ✓
#99 T 25-2 ✓

DOUGLAS COUNTY SURVEYORS OFFICE

T 25 S

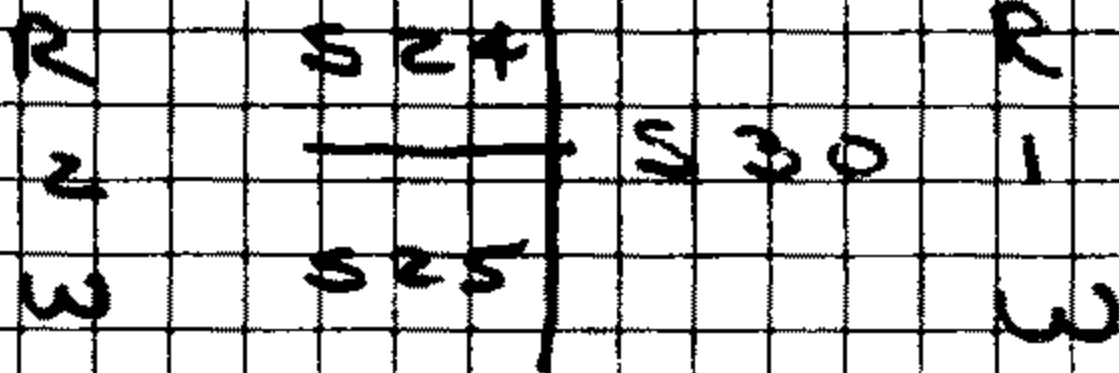

1976

A 10 INCH DIAMETER HEMLOCK
 2 BEARS S 50° W, 1212 FEET.
 TREE DOUBLE BLAZED AND
 SCRIBED " T 25 S R 2 W S 25
 CS BT "

MAG. DEC 20 E 6 - 10 - 76

L. E. MONREAN
 K. CHENEY

OK
[Signature]

DIETZGEN NO. 385-6