

RENEWAL

T 28 S R 7 W

NW COR. SEC. 5


SEE RENEWAL

# 137

FOUND

1. BRASS CAP AT SECTION CORNER  
MARKED

"U.S. GENERAL LAND OFFICE SURVEY"

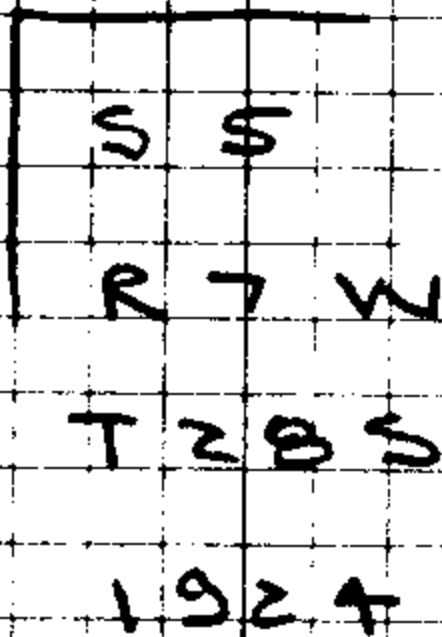

DIETZGEN NO. 385-6

2. A 20 INCH NOW AN 18 INCH DIAMETER  
ROTTED SNAG BEARS S 41° E, 33<sup>2</sup>  
FEET. SNAG SCRIBED "W S S BT".

3. AN <sup>2</sup> 18 NOW AN 18 INCH FIR BEARS  
S 8° E, 24<sup>2</sup> FEET. TREE HAS WELL  
HEALED BLAZE.

# 230 ✓

C. S. File No. 59/18-3

2  
4  
A 24 NOW 26 INCH DIAMETER  
W. FIR, NOW A WINDFALL  
BEARS S 49° E, 45° FEET.  
TREE HAS WELL HEALED BLAZE.

RENEWAL

1  
A 23 INCH DIAMETER D. FIR  
BEARS S 83½° E, 55 6 FEET,  
TREE DOUBLE BLAZED AND SCRIBED  
"T 28S R 7W S S CS BT".

MAG. DECLINATION  
20° E

7-8-76

L. E. MONREAN  
P. L. EARLE  
A. V. CANGIE

OK  
*[Signature]*

DIETZGEN NO. 385-6