

RENEWAL

C15 R3W
S19 520
S30 529

7-20-76

SEE RENEWAL # 60

FOUND

5/8 INCH DIAMETER

1. STEEL TUBE WITH

1 INCH DIAMETER ALUMINUM CAP
MARKED "PROPERTY CORNER".

2. A FIR 10 NOW AN 18 INCH DIAMETER

WINDFALL BEARS N 10° W, 48² FEET
NO SCRIBING FOUND.

3. A FIR 18 NOW A 38 INCH DIAMETER

STUMP BEARS S 85° W, 38² FEET.
NO SCRIBING FOUND.

4. A FIR 24 NOW 27 INCH DIAMETER

BEARS S 50° E, 46⁶ FEET. TREE

SCRIBED PER ORIGINAL "T 2 R 5"

LEGABLE, PER RENEWAL NUMBER 60

"S 29 R F 4 7/9 BT".

BEARING TREES PER RENEWAL NO. 60

5. A FIR 21 NOW A 22 INCH DIAMETER

STUMP BEARS N 62° E, 30⁷ FEET.

STUMP SCRIBED "PRL 4 0/9 BT"

DIETZEN NO. 385-6

#127 ✓

59/18-7

RENEWAL

FOUND

6. A RED CEDAR 9 NOW 11 INCHES DIAMETER
BEARS N 27° W, 22^S FEET. SCRIBE
VISIBLE IN PARTIALLY HEALED BLAZE.

RENEWAL

1. SET BRASS CAP AT SECTION CORNER
STAMPED;

" DOUGLAS COUNTY SURVEYORS OFFICE"
T 27 S R 3 W

S 19	S 20
S 30	S 29

1976

SET STEEL TUBE BESIDE CAP.

2. AN INCENSE CEDAR, 12 INCHES DIAMETER
BEARS N 59° E, 18^S FEET. TREE
BLAZED AND SCRIBED " T 27 S R 3 W
S 20 CS BT".

MAG. DECLINATION

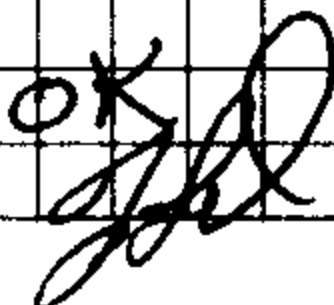
20° E

L. E. MONREAN

P. L. FARLE

K. CHENEY

J. H. COOK

OK 

DIETZEN NO. 385-6